

Orange County Surveyor

MANHOLE DETAIL:

JOB NO: JH YTC

DATE: 02/27/2024

CREW: LOFGREEN

STREET: JH YTC



TIME: 9:30 AM / PM

MANHOLE TYPE: SEWER

LID POINT NO: 490071

PHOTO NO: _____

PIPE MATERIAL: PVC

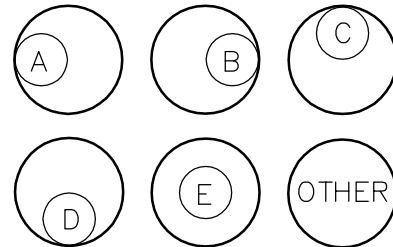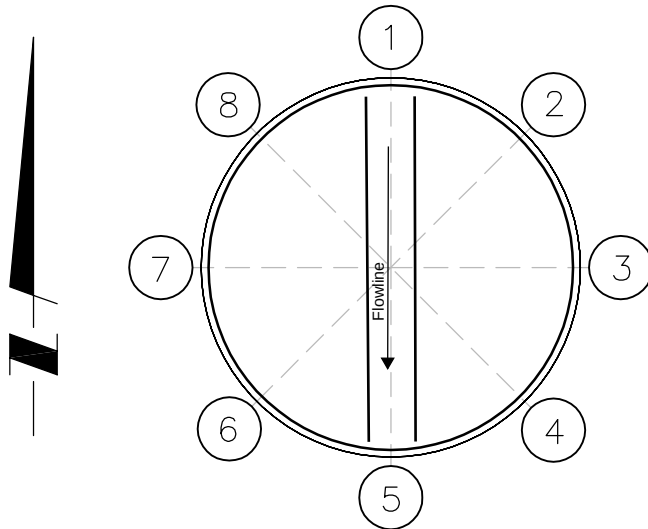

RIM OFFSET TYPE: D

POINT:	RIM ELEV:	INVERT:	F.L. ELEV:	PIPE DIA:	
1	130.66	13.08	117.58	10 IN	<u>WET</u> / DRY
2					WET / DRY
3					WET / DRY
4					WET / DRY
5	130.66		117.55	10 IN	<u>WET</u> / DRY
6					WET / DRY
7					WET / DRY
8					WET / DRY
CNTR:					WET / DRY