

Orange County Surveyor

MANHOLE DETAIL:

JOB NO: JH YTC

DATE: 02/27/2024

CREW: LOFGREEN

STREET: CAMPUS



TIME: 9:46 AM / PM

MANHOLE TYPE: SEWER

LID POINT NO: 490072

PHOTO NO: _____

PIPE MATERIAL: PVC

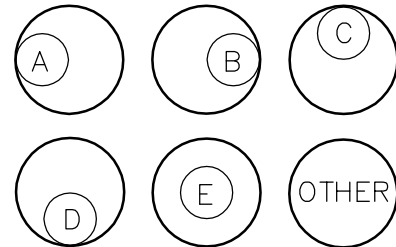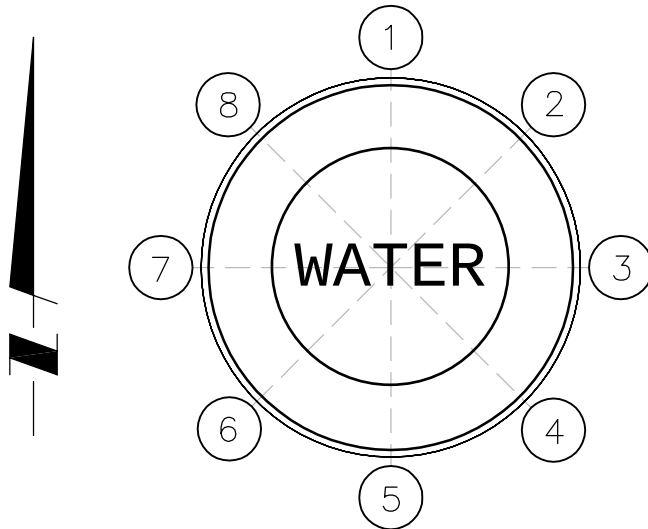

RIM OFFSET TYPE: _____

***MANHOLE IS FILLED WITH WATER**

POINT:	RIM ELEV:	INVERT:	F.L. ELEV:	PIPE DIA:	
1	_____	_____	_____	_____	WET / DRY
2	_____	_____	_____	_____	WET / DRY
3	_____	_____	_____	_____	WET / DRY
4	_____	_____	_____	_____	WET / DRY
5	_____	_____	_____	_____	WET / DRY
6	_____	_____	_____	_____	WET / DRY
7	_____	_____	_____	_____	WET / DRY
8	_____	_____	_____	_____	WET / DRY
CNTR:	_____	_____	_____	_____	WET / DRY