

Orange County Surveyor

MANHOLE DETAIL:

JOB NO: JH YTC

DATE: 02/27/2024

CREW: LOFGREEN

STREET: JH YTC



TIME: 8:40 AM / PM

MANHOLE TYPE: SEWER

LID POINT NO: 490273

PHOTO NO: _____

PIPE MATERIAL: _____

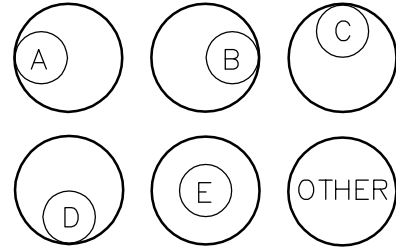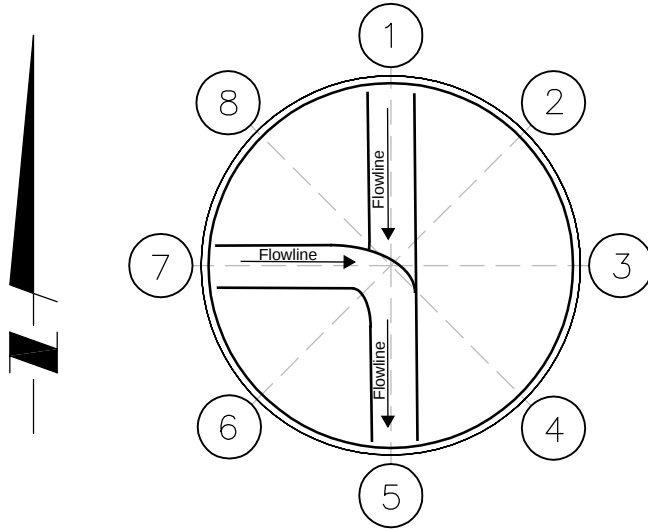

RIM OFFSET TYPE: D

POINT:	RIM ELEV:	INVERT:	F.L. ELEV:	PIPE DIA:	
1	133.88	15.21	118.67	8 IN	WET / <u>DRY</u>
2					WET / DRY
3					WET / DRY
4					WET / DRY
5	133.93	15.41	118.52	10 IN	<u>WET</u> / DRY
6					WET / DRY
7	133.92	15.45	118.59	10 IN	<u>WET</u> / DRY
8					WET / DRY
CNTR:					WET / DRY