


CITY OF ORANGE METROPOLITAN
CENTERLINE INTERSECTION TIES
TRACT or S.P. No. 1599

THE CITY DRIVE

MANCHESTER AVE AND E BC.

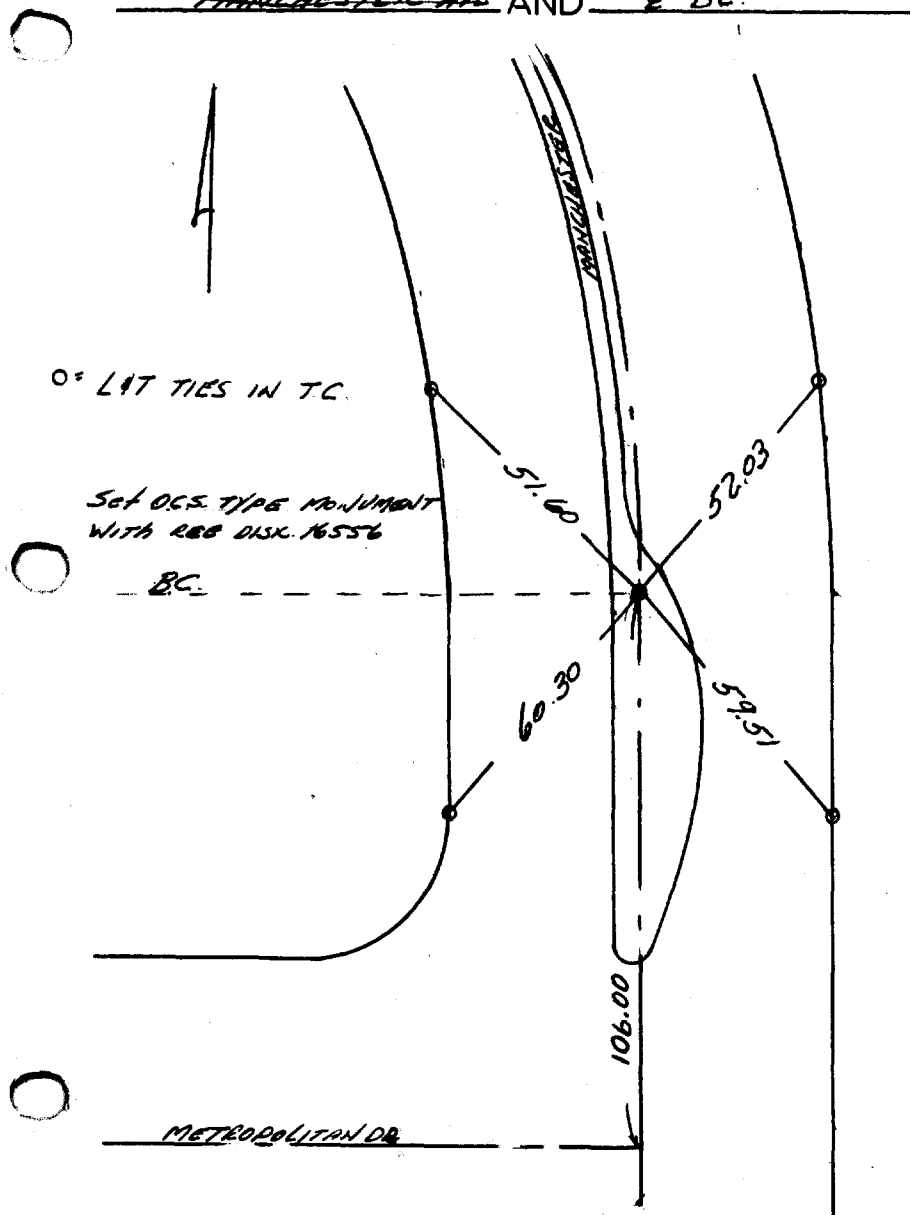

Surveyed by: CITY of ORANGE

Date: 11-16-71

me 1504