


GPS #: 0404

Date Destroyed:
Date Revised: 1/10/2013
Benchmark Designation:
OCS Index Map: 1L
Page/Grid: 739/A-6
City / Location: Fullerton

Scale Factor: 0.99999847
Ellipsoid Red. Factor: 0.99999671
Combination Factor: 0.99999518
Convergence Angle: -00 54 38.02630

Factors and Convergence Angle based on the 1991.35 Epoch Adjustment positions.

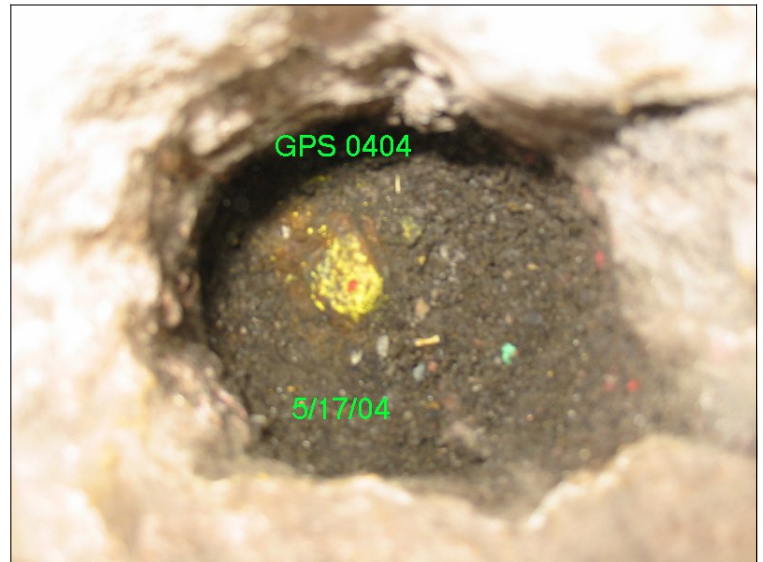

Epoch Adjustment	Latitude	Longitude	Northing (ft)	Easting (ft)	Ellipsoid Height (ft)
1991.35	33 52 26.70034	117 54 25.28020	2265678.149	6058706.829	
2007.00	33 52 26.71644	117 54 25.29720	2265679.80	6058705.42	

References: A/3-10 370, RSB 149/1-9, CR 2007-0251, CR 2010-2074, CR 2011-0112

Description:

FD ORIGINAL SPIKE DOWN 0.4' IN LIEU OF SPIKE AND WASHER STAMPED "EADSON & ASSOC LS 6154" PER CR 2011-0112 IN LIEU OF SQUARE HEAD BOLT, NO PUNCH, DOWN 0.4' BELOW SURFACE, AT THE CENTERLINE INTERSECTION OF CHAPMAN AVE. AND RAYMOND AVE.

