

GPS #: **0485R1**

Date Destroyed:

Date Revised: 4/5/2005

Benchmark Designation:

OCS Index Map: 1L

Page/Grid: 709/F-7

City / Location: Brea


Scale Factor: 1.00000602

Ellipsoid Red. Factor: 0.99998509

Combination Factor: 0.99999111

Convergence Angle: -00 53 12.59138

Factors and Convergence Angle based on the 1991.35 Epoch Adjustment positions.

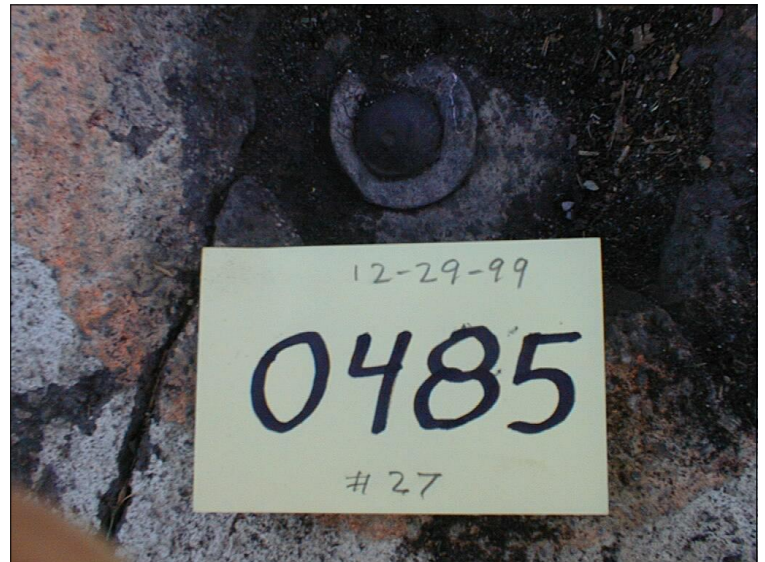

Epoch Adjustment	Latitude	Longitude	Northing (ft)	Easting (ft)	Ellipsoid Height (ft)
1991.35	33 55 05.70262	117 51 49.80760	2281543.646	6072063.138	
2007.00	33 55 05.71946	117 51 49.82438	2281545.37	6072061.75	

References: MM 419/9-13, RSB 149/1-9, CR 2004-1872, CR 2005-0147

Description:

FD MAG NAIL AND WASHER STAMPED "LS 6970" IN LIEU OF PUNCHED ROUND HEAD SPIKE AND WASHER STAMPED "RCE 20929". MONUMENT WAS RESET PER CORNER RECORD # 2005-0147. MONUMENT IS LOCATED AT THE CENTERLINE INTER OF KRAEMER BLVD. AND BIRCH ST.

