

GPS #: 3125

Date Destroyed: 6/8/2001

Date Revised:

Benchmark Designation:

OCS Index Map: 2L

Page/Grid: 799/H-3

City / Location: Orange


Scale Factor: 0.99998644

Ellipsoid Red. Factor: 0.99999566

Combination Factor: 0.99998210

Convergence Angle: -00 52 42.71887

Factors and Convergence Angle based on the 1991.35 Epoch Adjustment positions.

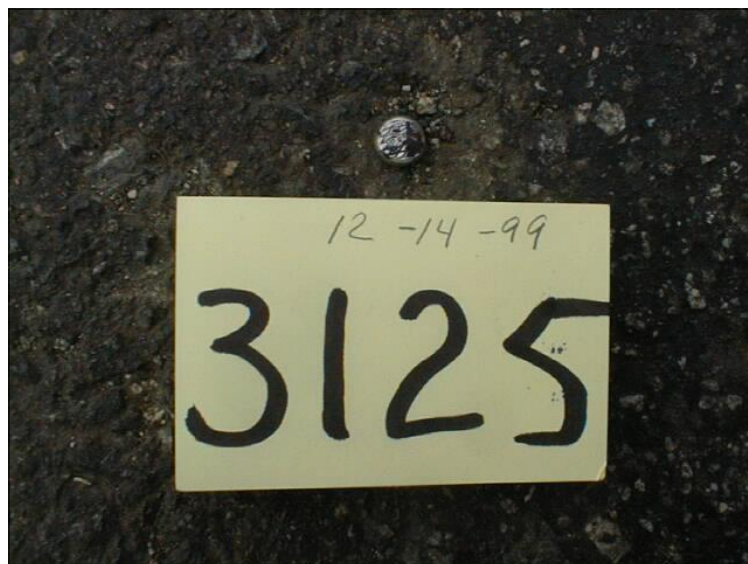

Epoch Adjustment	Latitude	Longitude	Northing (ft)	Easting (ft)	Ellipsoid Height (ft)
1991.35	33 47 42.36687	117 50 55.44625	2236663.516	6075956.779	90.728
2007.00	33 47 42.38333	117 50 55.46301	2236665.20	6075955.39	

References: RSB 149/10-20

Description:

REPORTED DESTROYED (SEE DATE IN DESTROYED BOX) - ORIGINAL DESCRIPTION BEING: FD PK NAIL, FLUSH. STATION IS LOCATED AT APPARENT CENTERLINE INTER OF WALNUT AVE. AND SHAFFER ST.

NO
LOCATION
MAP