

GPS #: **3145**

Date Destroyed:

Date Revised:

Benchmark Designation:

OCS Index Map: 2L

Page/Grid: 800/B-3

City / Location: Orange


Scale Factor: 0.99998654

Ellipsoid Red. Factor: 0.99999223

Combination Factor: 0.99997877

Convergence Angle: -00 51 52.82585

Factors and Convergence Angle based on the 1991.35 Epoch Adjustment positions.

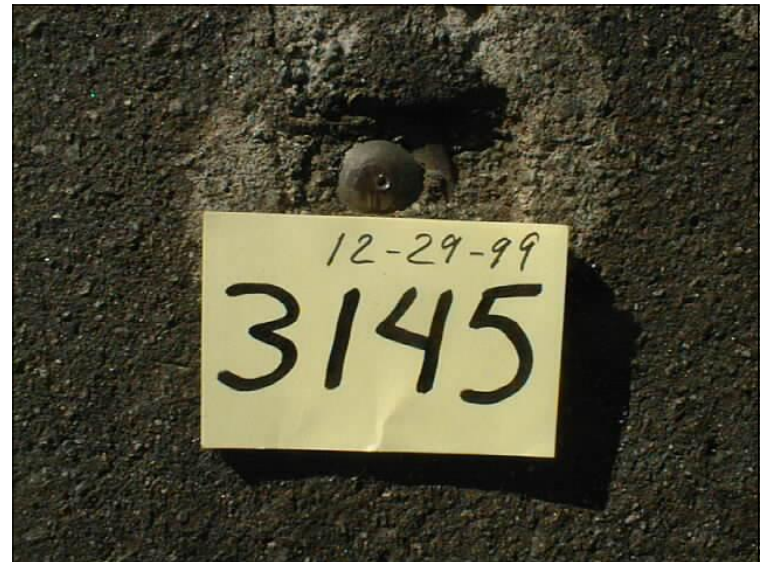

Epoch Adjustment	Latitude	Longitude	Northing (ft)	Easting (ft)	Ellipsoid Height (ft)
1991.35	33 47 44.86385	117 49 24.65202	2236799.329	6083622.249	162.457
2007.00	33 47 44.88018	117 49 24.66854	2236801.00	6083620.88	

References: MM 169/5-6, RSB 149/10-20

Description:

FD PUNCHED SPIKE AND WASHER, FLUSH. STATION IS LOCATED AT CENTERLINE INTER OF MALENA ST. AND MADISON AVE.

