

GPS #: 3530

Date Destroyed:

Date Revised:

Benchmark Designation:

OCS Index Map: 3L

Page/Grid: 738/B-7

City / Location: Fullerton


Scale Factor: 0.99999839

Ellipsoid Red. Factor: 1.00000104

Combination Factor: 0.99999944

Convergence Angle: -00 56 55.85867

Factors and Convergence Angle based on the 1991.35 Epoch Adjustment positions.

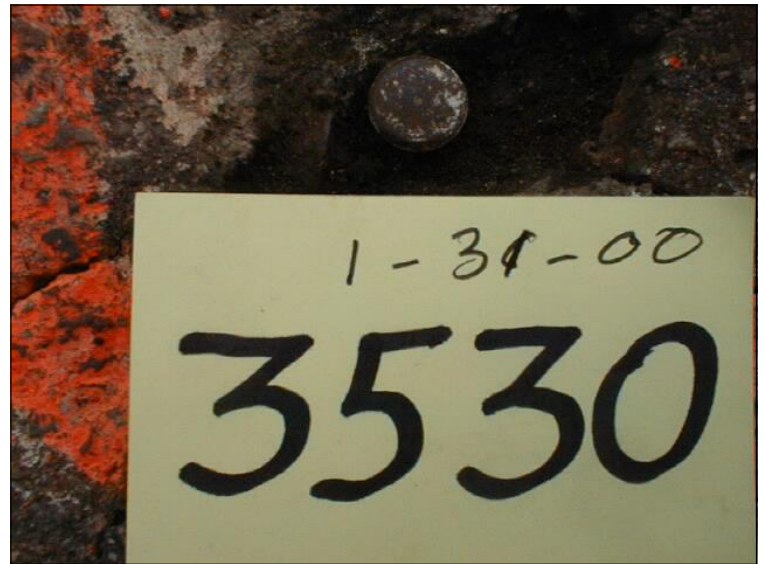

Epoch Adjustment	Latitude	Longitude	Northing (ft)	Easting (ft)	Ellipsoid Height (ft)
1991.35	33 52 25.04435	117 58 36.10449	2265853.933	6037557.816	-21.762
2007.00	33 52 25.06050	117 58 36.12184	2265855.59	6037556.38	

References: RSB 149/21-36

Description:

FD LARGE PK ON SURFACE. STATION IS LOCATED 450'+/- EAST OF 3801 ARTESIA BLVD. (LABEL-AIRE, INC.), AT APPARENT CENTERLINE POINT OF INTER OF CURVE (CONCAVE-SW'LY) IN ARTESIA BLVD.

