

**GPS #:** **3593**

Date Destroyed:

Date Revised: 5/28/2013

Benchmark Designation:

OCS Index Map: 3L

Page/Grid: 767/H-2

City / Location: Buena Park


Scale Factor: 0.99999602

Ellipsoid Red. Factor: 1.00000197

Combination Factor: 0.99999799

Convergence Angle: -00 57 46.85110

*Factors and Convergence Angle based on the 1991.35 Epoch Adjustment positions.*

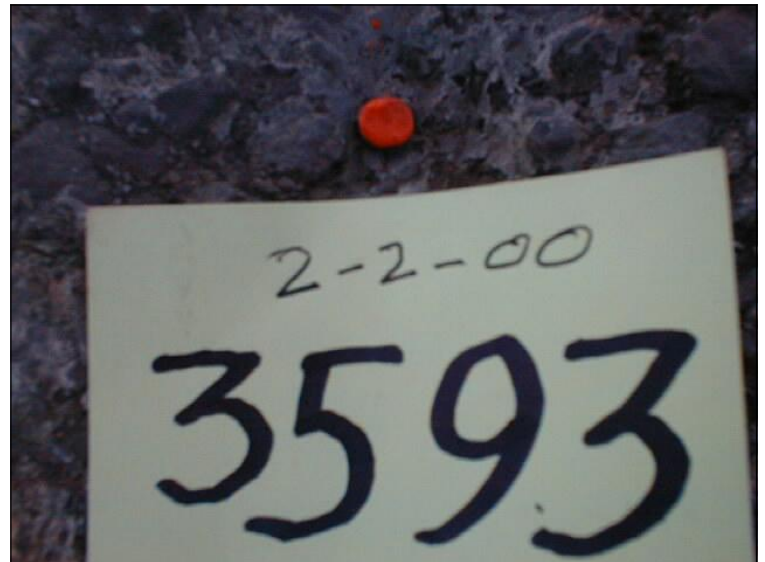

Epoch Adjustment	Latitude	Longitude	Northing (ft)	Easting (ft)	Ellipsoid Height (ft)
1991.35	33 51 32.23263	118 00 08.89940	2260646.709	6029644.850	-41.237
2007.00	33 51 32.24862	118 00 08.91751	2260648.35	6029643.35	

References: RSB 149/21-36, CR 2012-2248

**Description:**

RECOVERED PER CR 2012-2248, PREVIOUSLY REPORTED DESTROYED: FD NAIL, FLUSH. STATION IS LOCATED AT APPARENT CENTERLINE INTER OF WESTERN AVE. AND ORANGETHORPE AVE.

