

GPS #: 3709

Date Destroyed:

Date Revised:

Benchmark Designation:

OCS Index Map: 3L

Page/Grid: 767/H-6

City / Location: Anaheim


Scale Factor: 0.99999072

Ellipsoid Red. Factor: 1.00000225

Combination Factor: 0.99999297

Convergence Angle: -00 57 46.18648

Factors and Convergence Angle based on the 1991.35 Epoch Adjustment positions.

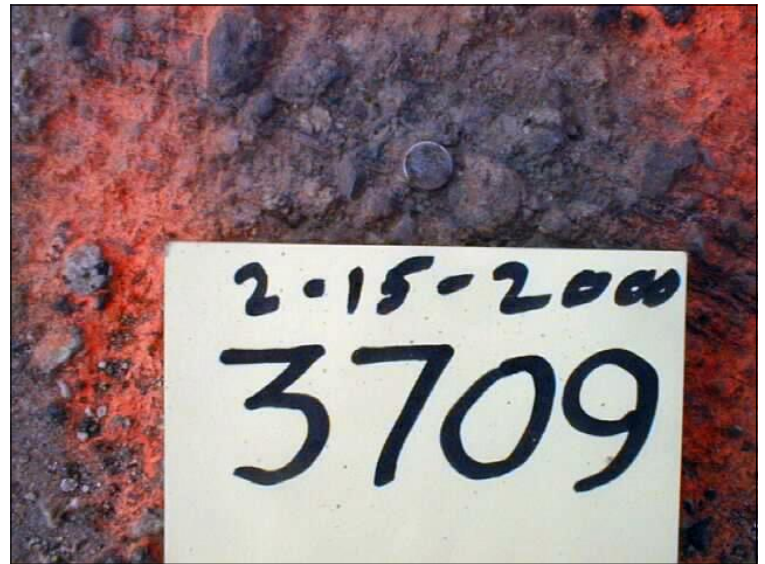

Epoch Adjustment	Latitude	Longitude	Northing (ft)	Easting (ft)	Ellipsoid Height (ft)
1991.35	33 49 28.69748	118 00 07.68993	2248159.204	6029536.996	-46.978
2007.00	33 49 28.71352	118 00 07.70739	2248160.85	6029535.55	

References: RSB 149/21-36

Description:

FD CONC. NAIL FLUSH AT THE APPARENT CENTERLINE INTER OF ORANGE AVE. AND WESTERN AVE.

