

GPS #: **3895**

Date Destroyed:

Date Revised: 3/12/2008

Benchmark Designation:

OCS Index Map: 3L

Page/Grid: 738/A-3

City / Location: La Mirada, Los Angeles Co.


Scale Factor: 1.00000258

Ellipsoid Red. Factor: 0.99999784

Combination Factor: 1.00000043

Convergence Angle: -00 57 13.75454

Factors and Convergence Angle based on the 1991.35 Epoch Adjustment positions.

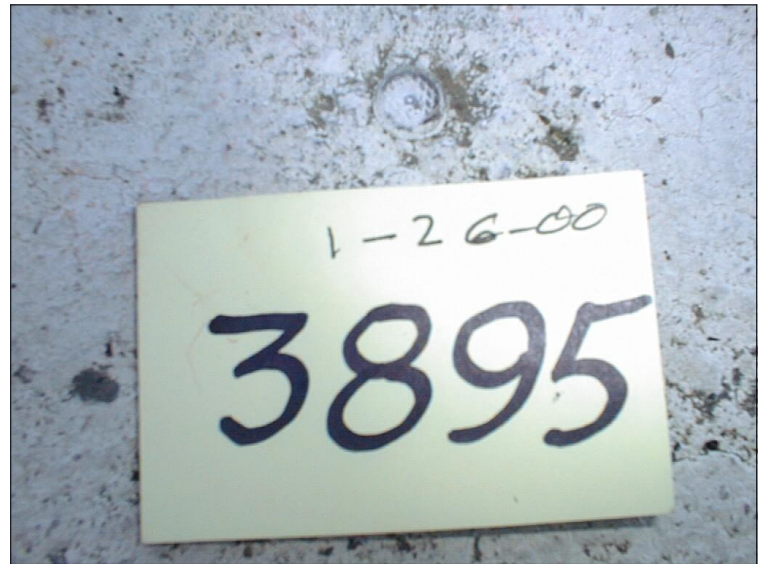

Epoch Adjustment	Latitude	Longitude	Northing (ft)	Easting (ft)	Ellipsoid Height (ft)
1991.35	33 53 54.83008	117 59 08.67101	2274974.390	6034963.320	45.098
2007.00	33 53 54.84626	117 59 08.68877	2274976.05	6034961.85	

References: RSB 149/21-36, CR 1998-0332, CR 2007-2026

Description:

FD PK NAIL IN CENTER OF AERIAL CROSS INSIDE A PAINTED MEDIAN ISLAND FLUSH WITH SURFACE LOCATED ALONG THE APPARENT CENTERLINE OF BEACH BLVD. 900'+/- N'LY FROM ITS INTER WITH ROSECRANS AVE.

