

GPS #: **4171**

Date Destroyed:

Date Revised: 10/4/2006

Benchmark Designation:

OCS Index Map: 4LA

Page/Grid: 828/H-3

City / Location: Santa Ana


Scale Factor: 0.99997982

Ellipsoid Red. Factor: 1.00000234

Combination Factor: 0.99998215

Convergence Angle: -00 55 21.07899

Factors and Convergence Angle based on the 1991.35 Epoch Adjustment positions.

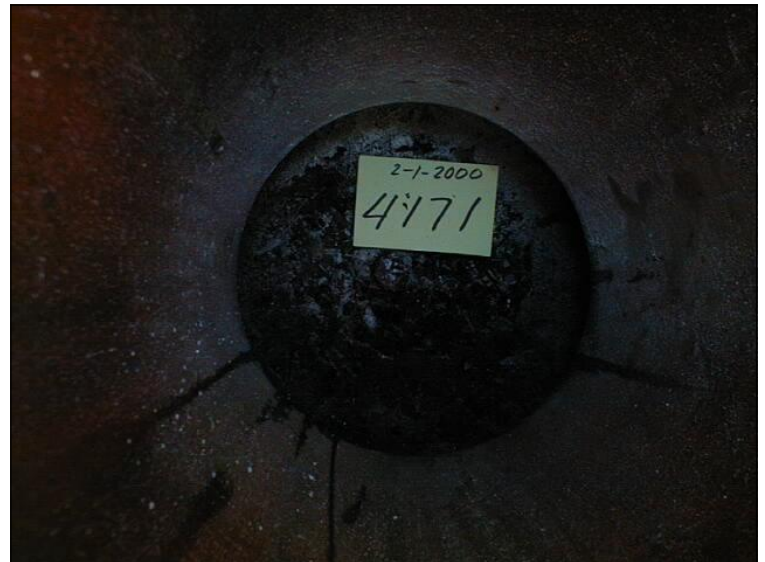

Epoch Adjustment	Latitude	Longitude	Northing (ft)	Easting (ft)	Ellipsoid Height (ft)
1991.35	33 44 42.39410	117 55 43.62653	2218855.959	6051346.008	-48.858
2007.00	33 44 42.41050	117 55 43.64339	2218857.64	6051344.61	

References: MM 580/36-39, RSB 149/37-43, CR 2003-0060, CR 2006-0870

Description:

FD PUNCHED HEX BAR, DOWN 1.6' IN O.C.S. WELL MONUMENT. STATION IS LOCATED AT CENTERLINE INTER OF NEWHOPE ST. AND FIRST ST.

