OC Public Works
OC Survey

Horizontal Control Data Sheet
CCS83, ZONE VI

GPS #: 4539R1

Date Destroyed:
Date Revised: 5/7/2003
Benchmark Designation:
OCS Index Map: 6LB
Page/Grid: 893/E-4
City / Location: Coto De Caza

Scale Factor: 0.99996764
Ellipsoid Red. Factor: 0.99995221
Combination Factor: 0.99991984
Convergence Angle: -00 43 15.48754

Factors and Convergance Angle based on the 1991.35 Epoch Adjustment positions.

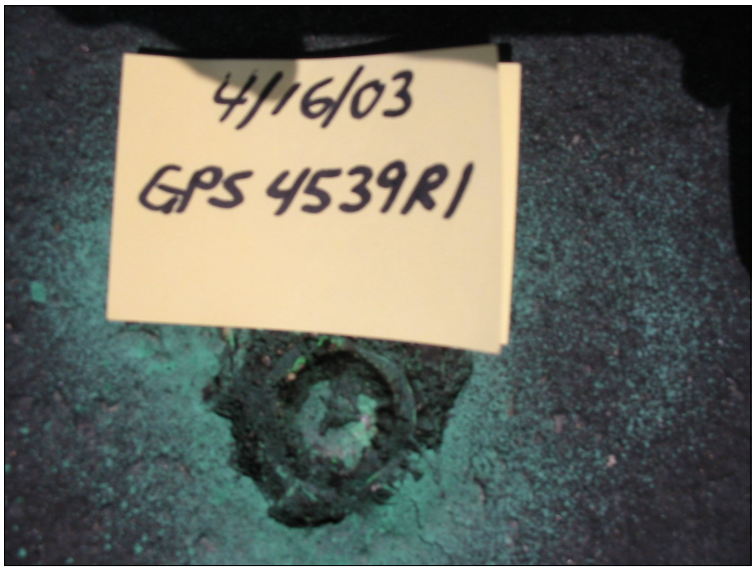

Epoch Adjustment	Latitude	Longitude	Northing (ft)	Easting (ft)	Ellipsoid Height (ft)
1991.35	33 37 55.51141	117 33 43.21116	2176132.216	6162316.973	
2007.00	33 37 55.52809	117 33 43.22657	2176133.92	6162315.69	

References: RSB 151/1-11, MM 649/33-38, CR 2003-1085

Description:
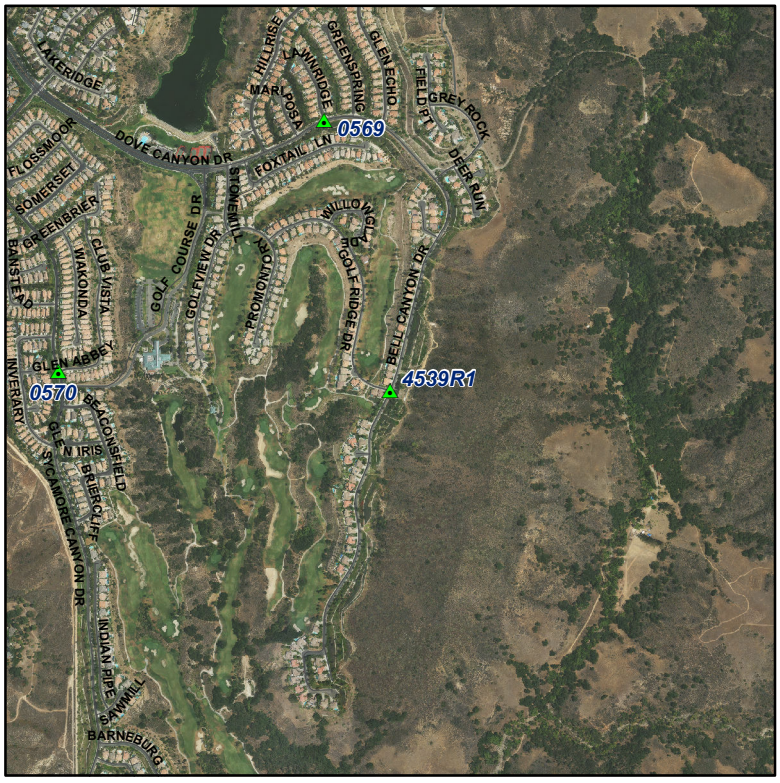
FD GEAR SPIKE AND WASHER STAMPED "RCE 23956" IN LIEU OF PK NAIL. MONUMENT HAS BEEN RESET PER CORNER RECORD # 2003-1085. MONUMENT IS LOCATED AT THE CENTERLINE INTERSECTION OF GOLF RIDGE DR. AND BELL CANYON DR.