

GPS #: 6127

Date Destroyed:

Date Revised:

Benchmark Designation:

OCS Index Map: 5LA

Page/Grid: 859/C-5

City / Location: Costa Mesa


Scale Factor: 0.99997234

Ellipsoid Red. Factor: 1.00000355

Combination Factor: 0.99997588

Convergence Angle: -00 54 10.34190

Factors and Convergence Angle based on the 1991.35 Epoch Adjustment positions.

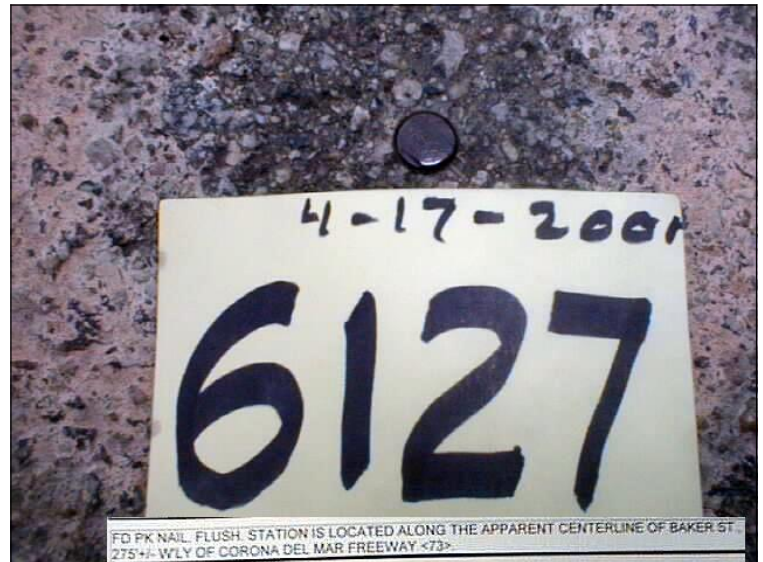

Epoch Adjustment	Latitude	Longitude	Northing (ft)	Easting (ft)	Ellipsoid Height (ft)
1991.35	33 40 48.37133	117 53 34.90071	2195030.459	6061841.892	-74.140
2007.00	33 40 48.38773	117 53 34.91749	2195032.14	6061840.50	

References: RSB 150/10-23

Description:

FD PK NAIL, FLUSH. STATION IS LOCATED ALONG THE APPARENT CENTERLINE OF BAKER ST., 275'+/- W'LY OF CORONA DEL MAR FREEWAY <73>.

