

HORIZONTAL CONTROL DATA SHEET CCS83, ZONE VI



GPS #: 6228R1

Date Destroyed:

Date Revised: 6/23/2017

Benchmark Designation:

Epoch Adjustment

1991.35

2007.00

OCS Index Map: 5LA
Page/Grid: 889/B-3
City / Location: Costa Mesa

Scale Factor: 0.99996876


Ellipsoid Red. Factor: 1.00000147

Combination Factor: 0.99997023

Convergence Angle: -00 54 32.57321

Factors and Convergance Angle based on the 1991.35 Epoch Adjustment positions.



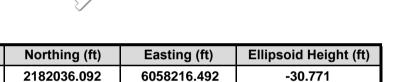

6058215.10

References: RSB 150/10-23, CR 2010-0763, CR 2010-1221

Latitude

33 38 39.26471

33 38 39.28110

Longitude

117 54 15.35677

117 54 15.37354

2182037.77

Description:

FD GEAR SPIKE & WASHER WITH TAG "LS 5411" IN LIEU OF ORIGINAL MONUMENT BEING PUNCHED SQUARE HEAD SPIKE AND 2" BRASS WASHER, STAMPED "COSTA MESA RCE 6579", DOWN 0.1' IN A.C. MONUMENT WAS RESET PER CR 2010-1221, STATION IS LOCATED AT APPARENT CENTERLINE INTER OF 21ST ST. AND SANTA ANA AVE.

