OC Public Works
OC Survey

Horizontal Control Data Sheet
CCS83, ZONE VI

GPS #: 6734R1

Date Destroyed:
Date Revised: 5/25/2015
Benchmark Designation:
OCS Index Map: 5LB
Page/Grid: 862/C-4
City / Location: Unin., Orange County

Scale Factor: 0.99997233
Ellipsoid Red. Factor: 0.99996121
Combination Factor: 0.99993354
Convergence Angle: -00 46 18.50374

Factors and Convergance Angle based on the 1991.35 Epoch Adjustment positions.

No Photo

Epoch Adjustment	Latitude	Longitude	Northing (ft)	Easting (ft)	Ellipsoid Height (ft)
1991.35	33 40 48.17427	117 39 16.26001	2193950.159	6134394.276	
2007.00	33 40 48.19093	117 39 16.27572	2193951.86	6134392.97	

References: RSB 150/24-35, CR 2015-0448

Description:
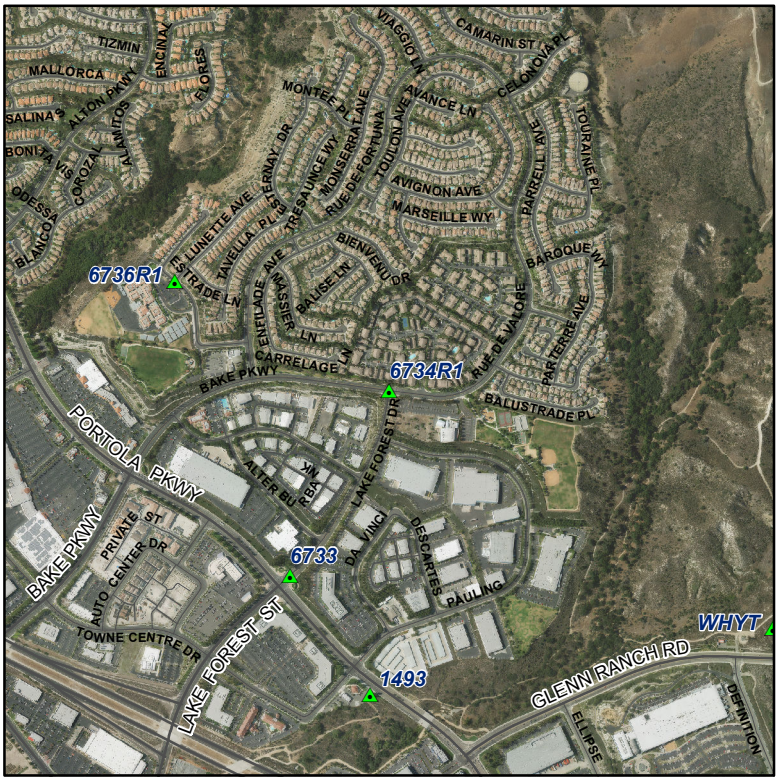
FD GEAR SPIKE AND WASHER STAMPED "LS 5411" FLUSH PER CR 2015-0448 IN LIEY OF SPIKE AND WASHER STAMPED "LS 4965". STATION IS LOCATED AT APPARENT CENTERLINE INTER OF LAKE FOREST DR. AND BAKE PKWY.