

GPS #: 7684

Date Destroyed:

Date Revised:

Benchmark Designation:

OCS Index Map: 6LA

Page/Grid: 921/J-3

City / Location: Laguna Hills


Scale Factor: 0.99996423

Ellipsoid Red. Factor: 0.99998653

Combination Factor: 0.99995076

Convergence Angle: -00 47 25.13197

Factors and Convergence Angle based on the 1991.35 Epoch Adjustment positions.

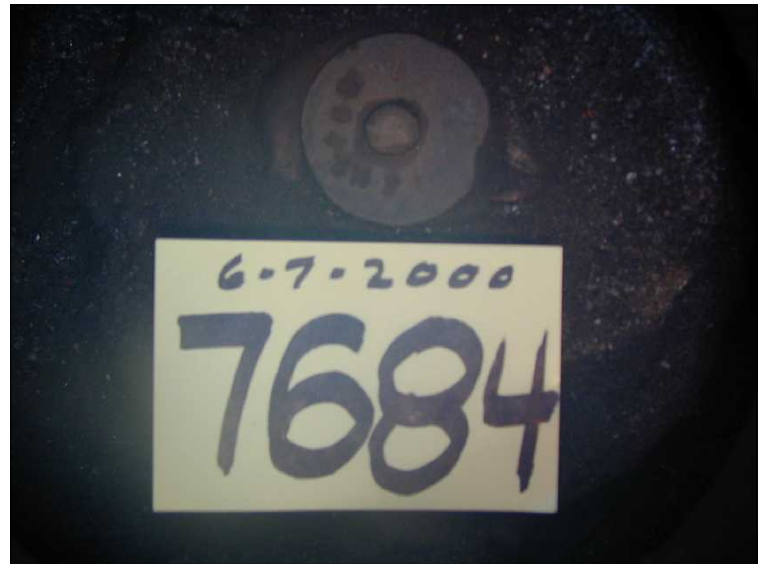

| Epoch Adjustment | Latitude | Longitude | Northing (ft) | Easting (ft) | Ellipsoid Height (ft) |
|------------------|----------------|-----------------|---------------|--------------|-----------------------|
| 1991.35 | 33 35 30.39711 | 117 41 17.50861 | 2161972.261 | 6123705.925 | 281.535 |
| 2007.00 | 33 35 30.41423 | 117 41 17.52466 | 2161974.01 | 6123704.59 | |

References: MM 393/41-46, RSB 150/36-50

Description:

FD 1 1/4" WASHER IN CONC., STAMPED "3248" WITH "x" PLACED OVER EACH NUMBER AND "LS 2304" WITH NO "x", DOWN 0.90' IN WELL MONUMENT. STATION IS LOCATED AT CENTERLINE B.C. ALONG ALISAL AVE., 0.15+/- MILE S'LY OF PASEO DE VALENCIA.

