

GPS #: 7802

Date Destroyed:

Date Revised: 5/9/2005

Benchmark Designation:

OCS Index Map: 5LA

Page/Grid: 919/A-1

City / Location: Newport Beach


Scale Factor: 0.99996543

Ellipsoid Red. Factor: 1.00001669

Combination Factor: 0.99998212

Convergence Angle: -00 55 05.05930

Factors and Convergence Angle based on the 1991.35 Epoch Adjustment positions.

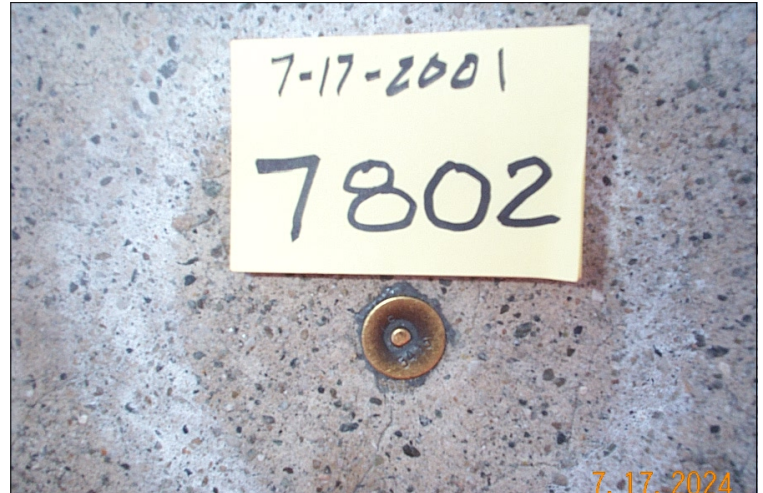

Epoch Adjustment	Latitude	Longitude	Northing (ft)	Easting (ft)	Ellipsoid Height (ft)
1991.35	33 36 23.83068	117 55 14.47424	2168428.022	6052999.938	-348.772
2007.00	33 36 23.84715	117 55 14.49133	2168429.71	6052998.52	

References: CR 2002-0822

Description:

RECOVERED 5/9/05 - ORIGINAL DESCRIPTION BEING: FD LEAD AND NAIL WITH 3/4" BRASS TAG STAMPED "LS 5415", FLUSH IN CONC. MONUMENT IS LOCATED ALONG THE CENTERLINE OF 15TH STREET AND 120.00' SOUTHERLY FROM THE CENTERLINE OF BALBOA BLVD.

