

Designation: 1C-102-69

Date Destroyed:

Date Revised:

GPS #:

OCS Index Map: Q05-15


Page/Grid: 827/D-1

City / Location: Westminster

Line #/SSN: 153/0200

Established By: OCS 1968

Monument Type: Orange County Surveyor's 3 3/4"
Aluminum Disk

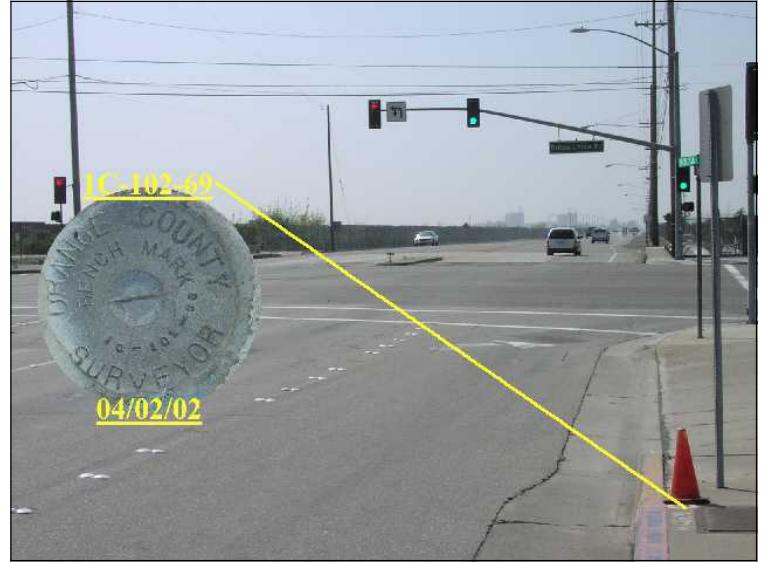

NAVD88 (ft)	NGVD29 (ft)	Year Leveled
20.652	18.235	2005
20.759	18.298	1989

For Reconnaissance Only!	
Latitude (30' +/-)	Longitude (30' +/-)
33 45 34.36	118 02 31.65

Description:

DESCRIBED BY OCS 2002 - FOUND 3 3/4" OCS ALUMINUM BENCHMARK DISK STAMPED "1C-102-69", SET IN THE SOUTHWESTERLY CORNER OF A 4 FT. BY 8 FT. CONCRETE CATCH BASIN. MONUMENT IS LOCATED IN THE NORTHEASTERLY CORNER OF THE INTERSECTION OF WESTMINSTER BOULEVARD AND BOLSA CHICA ROAD, 43 FT. NORTHERLY OF THE CENTERLINE OF WESTMINSTER AND 142 FT. EASTERLY OF THE CENTERLINE OF BOLSA CHICA. MONUMENT IS SET LEVEL WITH THE SIDEWALK.

