

Designation: 1C-103-69

Date Destroyed:

Date Revised:

GPS #:

OCS Index Map: Q05-15


Page/Grid: 827/E-1

City / Location: Westminster

Line #/SSN: 153/0190

Established By: OCS 1968

Monument Type: Orange County Surveyor's 3 3/4"
Aluminum Disk

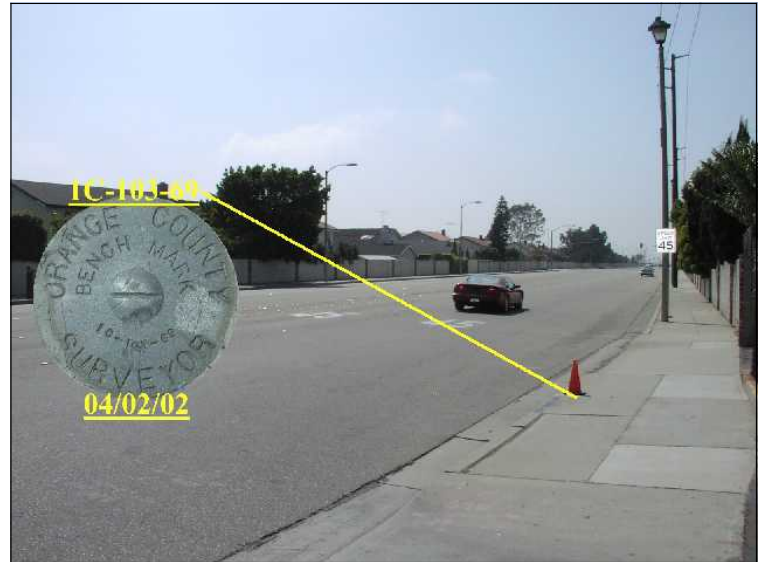

NAVD88 (ft)	NGVD29 (ft)	Year Leveled
23.935	21.518	2005
24.052	21.594	1989

For Reconnaissance Only!	
Latitude (30' +/-)	Longitude (30' +/-)
33 45 34.22	118 02 01.97

Description:

DESCRIBED BY OCS 2002 - FOUND 3 3/4" OCS ALUMINUM BENCHMARK DISK STAMPED "1C-103-69", SET IN THE SOUTHWESTERLY CORNER OF A 4 FT. BY 5 FT. CONCRETE CATCH BASIN. MONUMENT IS LOCATED IN THE NORTHWESTERLY CORNER OF THE INTERSECTION OF WESTMINSTER BOULEVARD AND MILAN STREET, 44 FT. NORTHERLY OF THE CENTERLINE OF WESTMINSTER AND 115 FT. WESTERLY OF MILAN. MONUMENT IS SET LEVEL WITH THE TOP OF THE CURB.

