

**Designation: 1C-123-74**

Date Destroyed:

Date Revised:

GPS #:

OCS Index Map: Q10-02


Page/Grid: 826/G-4

City / Location: Seal Beach

Line #/SSN: 401/0010

Established By: OCS 1974

Monument Type: Orange County Surveyor's 3 3/4"  
Aluminum Disk

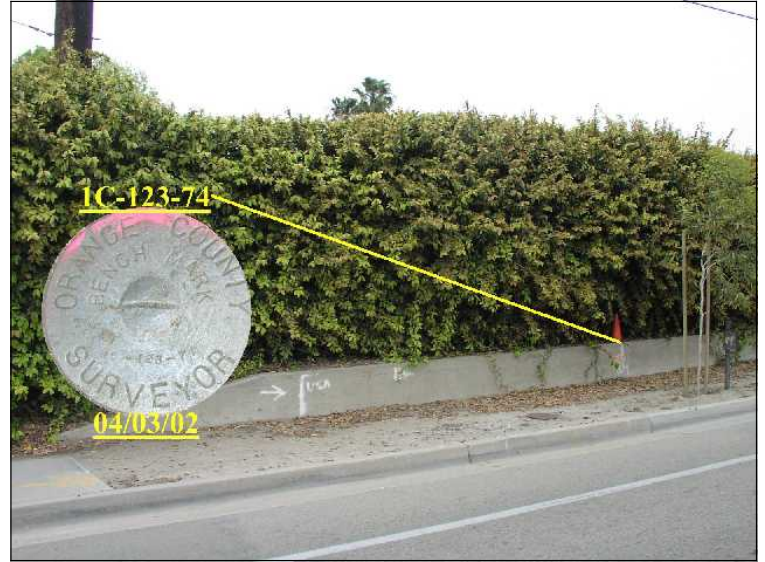

NAVD88 (ft)	NGVD29 (ft)	Year Leveled
35.841	33.423	2005
35.933	33.448	1989

For Reconnaissance Only!	
Latitude (30' +/-)	Longitude (30' +/-)
33 44 43.63	118 05 32.79

**Description:**

DESCRIBED BY OCS 2002 - FOUND 3 3/4" OCS ALUMINUM BENCHMARK DISK STAMPED "1C-123-74", SET IN THE TOP OF A 2.5 FT. HIGH RETAINING WALL. MONUMENT IS LOCATED IN THE NORTHWESTERLY CORNER OF THE INTERSECTION OF SEAL BEACH BOULEVARD AND BOLSA AVENUE, 180 FT. NORTHERLY OF THE CENTERLINE OF BOLSA AVENUE AND 8 FT. WESTERLY OF THE WEST CURB ALONG SEAL BEACH BOULEVARD. MONUMENT IS SET 2.5 FT. HIGHER THAN THE GROUND.

