

**Designation: 1F-161-92**

Date Destroyed:

Date Revised:

GPS #:

OCS Index Map: Q06-11


Page/Grid: 798/J-5

City / Location: Anaheim

Line #/SSN: 156/0230

Established By: OCS 1992

Monument Type: Orange County Surveyor's 3 3/4"  
Aluminum Disk

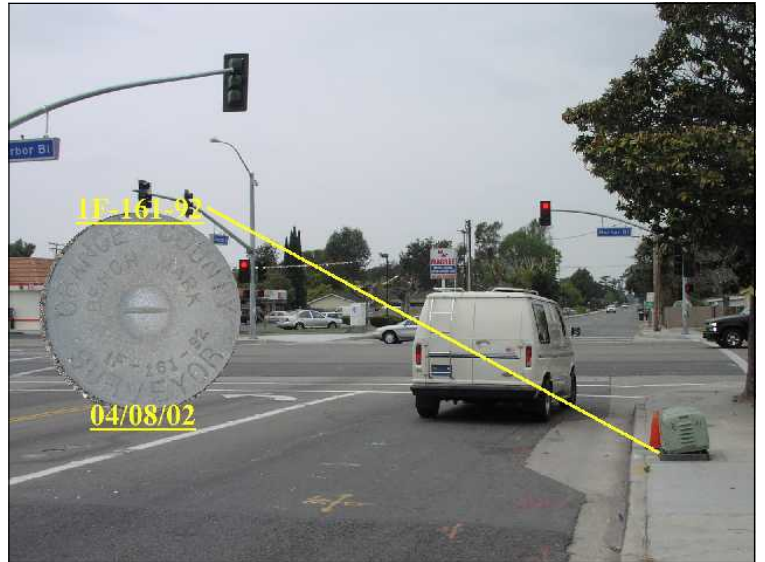

NAVD88 (ft)	NGVD29 (ft)	Year Leveled
111.988	109.573	2010
111.988	109.573	2005
112.121	109.677	1992

For Reconnaissance Only!	
Latitude (30' +/-)	Longitude (30' +/-)
33 46 54.14	117 54 52.33

**Description:**

DESCRIBED BY OCS 2002 - FOUND 3 3/4" OCS ALUMINUM BENCHMARK DISK STAMPED "1F-161-92", SET IN THE SOUTHEASTERLY CORNER OF A 4 FT. BY 10 FT. CONCRETE CATCH BASIN. MONUMENT IS LOCATED IN THE NORTHEASTERLY CORNER OF THE INTERSECTION OF LAMPSON AVENUE AND HARBOR BOULEVARD, 92 FT. EASTERLY OF THE CENTERLINE OF HARBOR BOULEVARD AND 25 FT. NORTHERLY OF THE CENTERLINE OF LAMPSON AVENUE. MONUMENT IS SET LEVEL WITH THE SIDEWALK.

