

**Designation: 1F-167-99**

Date Destroyed: 10/31/2014

Date Revised: 10/31/2014

GPS #:

OCS Index Map: Q06-15


Page/Grid: 828/J-1

City / Location: Garden Grove

Line #/SSN: 156/0370

Established By: OCS 1999

Monument Type: Orange County Surveyor's 3 3/4"  
Aluminum Disk

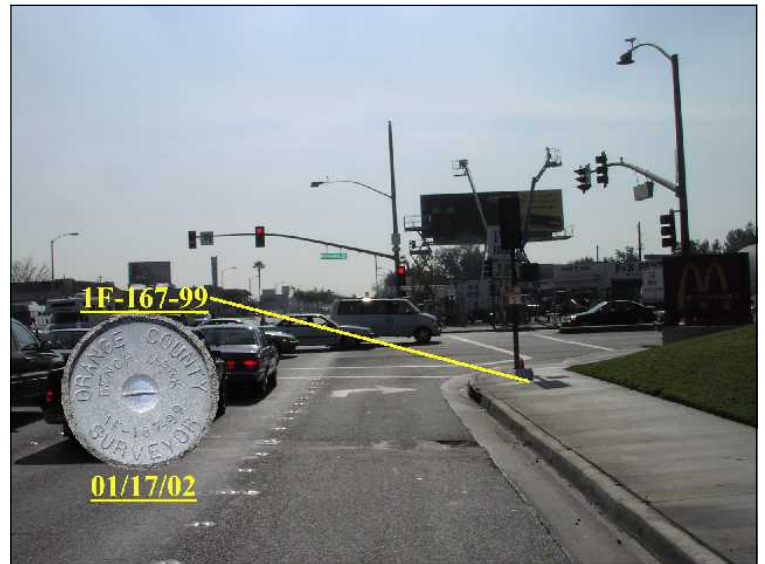

NAVD88 (ft)	NGVD29 (ft)	Year Leveled
87.063	84.649	2010
87.063	84.649	2005
87.248	84.810	1999

For Reconnaissance Only!	
Latitude (30' +/-)	Longitude (30' +/-)
33 45 36.01	117 55 13.57

**Description:**

REPORTED DESTROYED (SEE DATE IN DESTROYED BOX) - ORIGINAL DESCRIPTION BEING: DESCRIBED BY OCS 2002 - FOUND 3 3/4" OCS ALUMINUM BENCHMARK DISK STAMPED "1F-167-99" SET ON TOP OF THE SOUTHWEST CORNER OF A 4 FT. BY 8 FT. CONCRETE CATCH BASIN. MONUMENT IS LOCATED IN THE NORTHWEST PORTION OF THE INTERSECTION OF HARBOR BOULEVARD AND WESTMINSTER AVENUE, 60' WEST OF THE CENTERLINE OF HARBOR BOULEVARD AND 65' NORTH OF THE CENTERLINE OF WESTMINSTER AVENUE. MONUMENT IS SET LEVEL WITH THE SIDEWALK.

