


Designation: 1F-173-04

Date Destroyed:
Date Revised: 4/29/2004
GPS #:
OCS Index Map: Q06-07
Page/Grid: 768/J-6
City / Location: Anaheim

Line #/SSN: 156/0430
Established By: OCS 2004
Monument Type: Orange County Surveyor's 3 3/4" Aluminum Disk

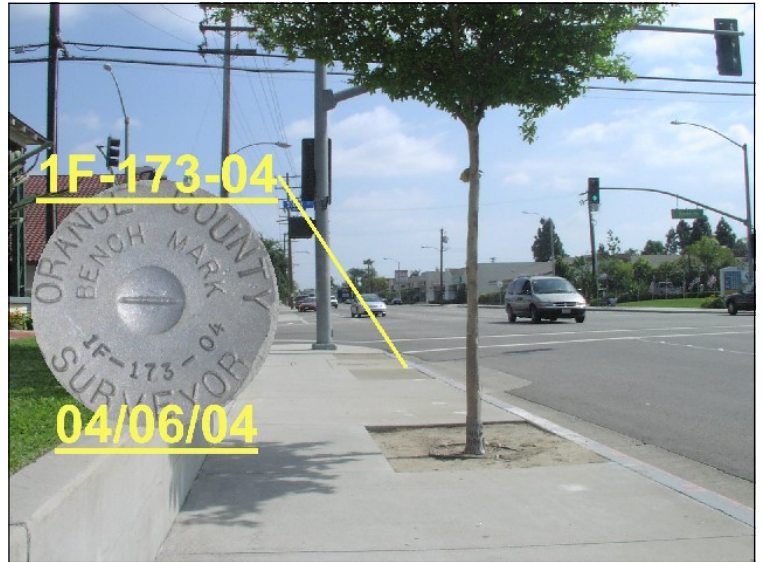

NAVD88 (ft)	NGVD29 (ft)	Year Leveled
147.653	145.235	2005
147.724	145.279	2004

For Reconnaissance Only!	
Latitude (30' +/-)	Longitude (30' +/-)
33 49 32.18	117 54 59.78

Description:
 DESCRIBED BY OCS 2004 - FOUND 3 3/4" OCS ALUMINUM BENCHMARK DISK STAMPED "1F-173-04", SET IN THE NORTHWESTERLY CORNER OF A 4 FT. BY 8.5 FT. CONCRETE CATCH BASIN. MONUMENT IS LOCATED IN THE NORTHEASTERLY CORNER OF THE INTERSECTION OF HARBOR BOULEVARD AND SOUTH STREET, 33 FT. EASTERLY OF THE CENTER OF THE MEDIAN ALONG HARBOR AND 55 FT. WESTERLY OF THE CENTERLINE OF SOUTH STREET. MONUMENT IS SET LEVEL WITH THE SIDEWALK.

