

Designation: 1M-15-04

Date Destroyed:

Date Revised: 4/11/2004

GPS #:

OCS Index Map: Q06-06


Page/Grid: 768/E-5

City / Location: Anaheim

Line #/SSN: 163/0150

Established By: OCS 2004

Monument Type: Orange County Surveyor's 3 3/4"
Aluminum Disk

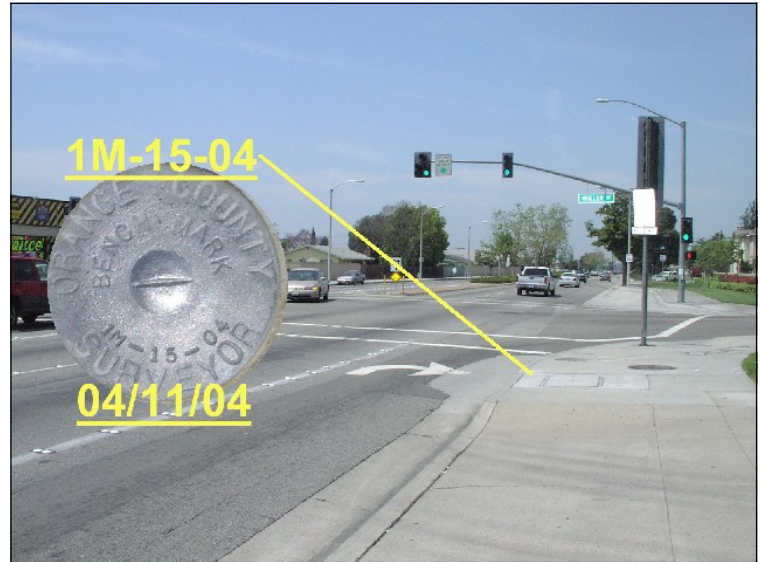

NAVD88 (ft)	NGVD29 (ft)	Year Leveled
119.540	117.120	2005
119.627	117.170	2004

For Reconnaissance Only!	
Latitude (30' +/-)	Longitude (30' +/-)
33 49 57.43	117 56 59.80

Description:

DESCRIBED BY OCS 2004 - FOUND 3 3/4" OCS ALUMINUM BENCHMARK DISK STAMPED "1M-15-04", SET IN THE SOUTHEASTERLY CORNER OF A 9 FT. BY 9 FT. CONCRETE CATCH BASIN. MONUMENT IS LOCATED IN THE NORTHEASTERLY CORNER OF THE INTERSECTION OF MULLER STREET AND LINCOLN AVENUE, 54 FT. EASTERLY OF THE CENTERLINE OF MULLER AND 39 FT. NORTHERLY OF THE CENTERLINE OF LINCOLN AVENUE. MONUMENT IS SET LEVEL WITH THE SIDEWALK.

