

**Designation: 1M-7-82**

Date Destroyed:

Date Revised:

GPS #:

OCS Index Map: Q05-08


Page/Grid: 767/F-5

City / Location: Buena Park

Line #/SSN: 163/0070

Established By: OCS 1982

Monument Type: Orange County Surveyor's 3 3/4"  
Aluminum Disk

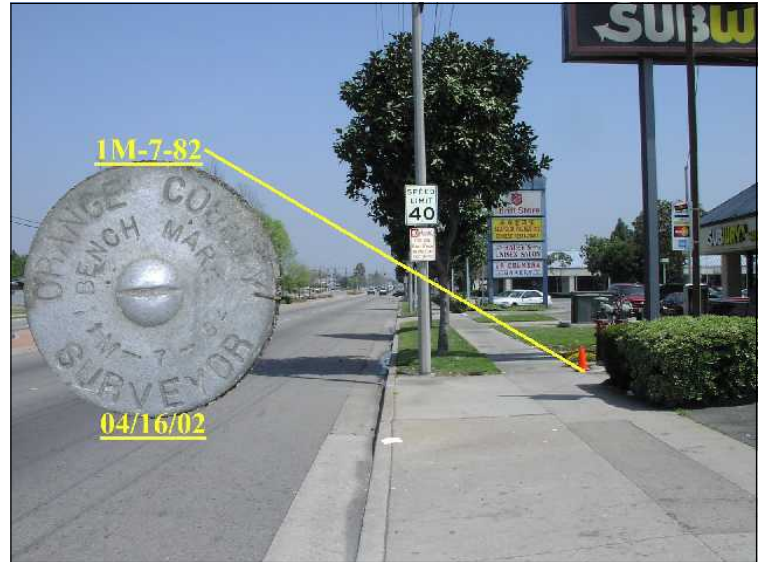

NAVD88 (ft)	NGVD29 (ft)	Year Leveled
76.803	74.382	2005
76.905	74.439	1990

For Reconnaissance Only!	
Latitude (30' +/-)	Longitude (30' +/-)
33 49 54.7	118 00 05.7

**Description:**

DESCRIBED BY OCS 2002 - FOUND 3 3/4" OCS ALUMINUM BENCHMARK DISK STAMPED "1M-7-82", SET IN THE NORTHWESTERLY CORNER OF A 9.2 FT. BY 5.8 FT. CONCRETE VAULT. MONUMENT IS LOCATED IN THE SOUTHEASTERLY CORNER OF THE INTERSECTION OF LINCOLN AVENUE AND WESTERN AVENUE, 190.5 FT. EASTERLY OF THE CENTERLINE OF WESTERN AND 53 FT. SOUTHERLY OF THE CENTERLINE OF LINCOLN. MONUMENT IS SET LEVEL WITH THE SIDEWALK.

