

Designation: 2B-49-05

Date Destroyed:

Date Revised:

GPS #:

OCS Index Map: Q02-11


Page/Grid: 708/J-7

City / Location: Brea

Line #/SSN: 252/0140

Established By: OCS 2005

Monument Type: Orange County Surveyor's 3 3/4"
Aluminum Disk

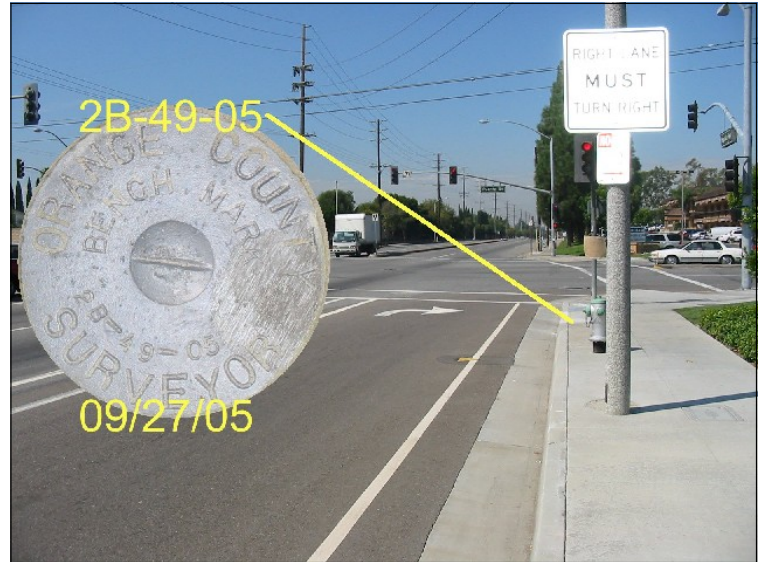

NAVD88 (ft)	NGVD29 (ft)	Year Leveled
326.429	324.011	2005

For Reconnaissance Only!	
Latitude (30' +/-)	Longitude (30' +/-)
33 55 03.03	117 54 55.33

Description:

DESCRIBED BY OCS 2005 - FOUND 3 3/4" OCS ALUMINUM BENCHMARK DISK STAMPED "2B-49-05", SET IN THE SOUTHEASTERLY CORNER OF A 4 FT. BY 12 FT. CONCRETE CATCH BASIN. MONUMENT IS LOCATED IN THE NORTHEASTERLY CORNER OF THE INTERSECTION OF IMPERIAL HIGHWAY AND PUENTE. 52 FT. NORTHERLY OF THE CENTERLINE OF IMPERIAL HIGHWAY AND 78 FT. EASTERLY OF THE CENTERLINE OF PUENTE. MONUMENT IS SET LEVEL WITH THE SIDEWALK

