

Designation: 2C-102-76

Date Destroyed:

Date Revised:

GPS #:

OCS Index Map: Q03-09


Page/Grid: 709/E-7

City / Location: Brea

Line #/SSN: 253/0120

Established By: OCS 1976

Monument Type: Orange County Surveyor's 3 3/4"
Aluminum Disk

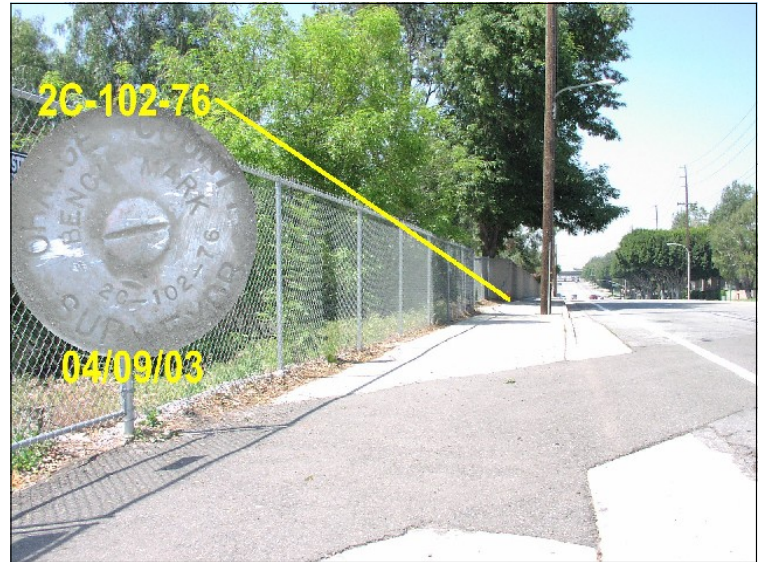

NAVD88 (ft)	NGVD29 (ft)	Year Leveled
375.931	373.516	2006
376.062	373.649	1990

For Reconnaissance Only!	
Latitude (30' +/-)	Longitude (30' +/-)
33 55 04.90	117 52 23.37

Description:

DESCRIBED BY OCS 2003 - FOUND 3 3/4" OCS ALUMINUM BENCHMARK DISK STAMPED "2C-102-76", SET IN THE TOP OF A 6 IN. BY 6 IN. CONCRETE POST. MONUMENT IS LOCATED ALONG THE SOUTHERLY SIDE OF BIRCH STREET, 0.5 MILES EASTERLY OF THE 57 FREEWAY, 41 FT. SOUTHERLY OF THE CENTERLINE OF BIRCH STREET, 3.5 FT. EASTERLY OF THE NORTHEASTERLY CORNER OF 6 FT. HIGH BLOCK WALL AND 0.5 FT. SOUTHERLY OF THE SOUTHERLY EDGE OF A SIDEWALK. MONUMENT IS SET LEVEL WITH THE SIDEWALK.

