

Designation: 2C-112-90

Date Destroyed:

Date Revised:

GPS #:

OCS Index Map: Q07-02


Page/Grid: 769/J-1

City / Location: Anaheim

Line #/SSN: 403/0630

Established By: OCS 1990

Monument Type: Orange County Surveyor's 3 3/4"
Aluminum Disk

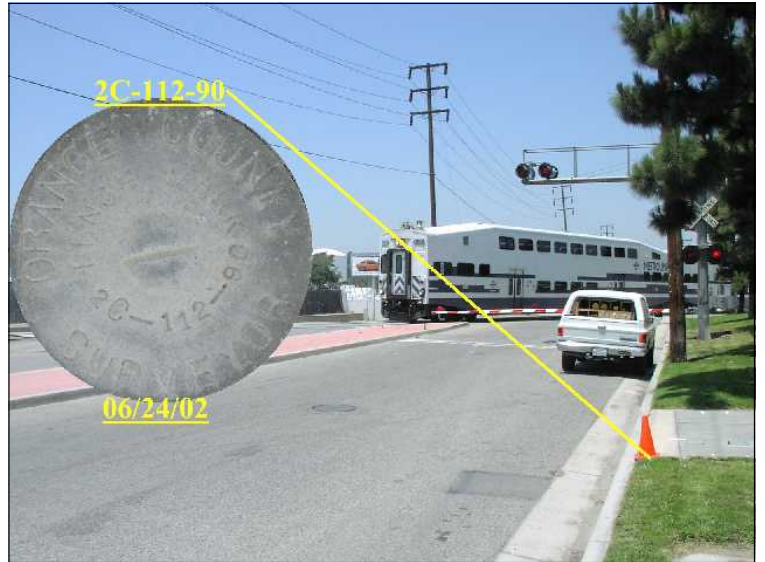

NAVD88 (ft)	NGVD29 (ft)	Year Leveled
243.757	241.351	2006
243.823	241.431	1988

For Reconnaissance Only!	
Latitude (30' +/-)	Longitude (30' +/-)
33 51 51.79	117 50 13.04

Description:

DESCRIBED BY OCS 2002 - FOUND 3 3/4" OCS ALUMINUM BENCHMARK DISK STAMPED "2C-112-90", SET IN THE SOUTHWESTERLY CORNER OF A 7 FT. BY 13 FT. CONCRETE WATER VAULT. MONUMENT IS LOCATED ALONG THE EASTERLY SIDE OF JEFFERSON STREET, 32 FT. EASTERLY OF THE CENTERLINE OF JEFFERSON AND 174 FT. SOUTHERLY OF THE CENTERLINE OF THE ATCHINSON TOPEKA AND SANTA FE RAILWAY. MONUMENT IS SET LEVEL WITH THE TOP OF THE VAULT.

