

Designation: 3A-112-79

Date Destroyed: **4/11/2011**

Date Revised: 7/2/2007

GPS #:

OCS Index Map: Q07-11


Page/Grid: 800/D-1

City / Location: Orange

Line #/SSN: 351/0230

Established By: OCS 1979

Monument Type: Orange County Surveyor's 3 3/4"
Aluminum Disk

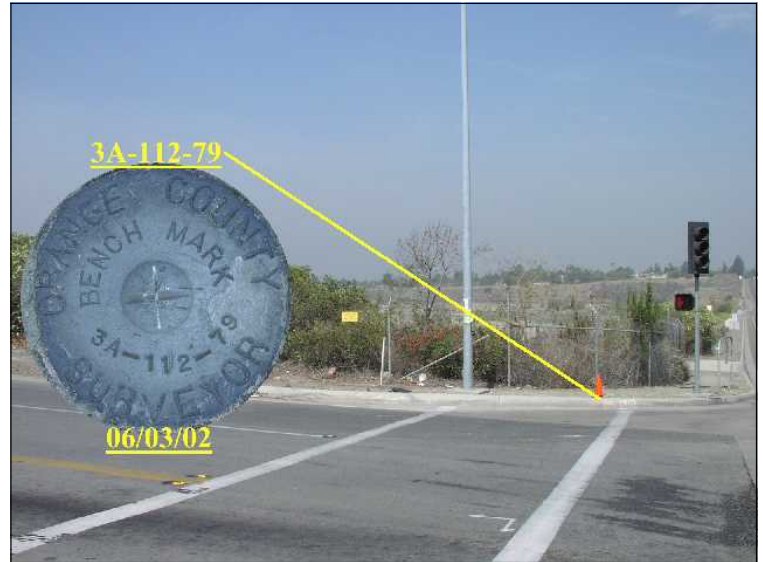

NAVD88 (ft)	NGVD29 (ft)	Year Leveled
335.211	332.788	2010
335.123	332.703	1992

For Reconnaissance Only!	
Latitude (30' +/-)	Longitude (30' +/-)
33 48 35.55608	117 48 03.67017

Description:

REPORTED DESTROYED (SEE DATE IN DESTROYED BOX) - ORIGINAL DESCRIPTION BEING: DESCRIBED BY OCS 2002 - FOUND 3 3/4" OCS ALUMINUM BENCHMARK DISK STAMPED "3A-112-79", SET IN THE TOP OF A 6 IN. BY 6 IN. CONCRETE POST. MONUMENT IS LOCATED IN THE SOUTHWESTERLY CORNER OF THE INTERSECTION OF HEWES STREET AND VILLA PARK ROAD, 54.5 FT. SOUTHERLY OF THE CENTERLINE OF VILLA PARK ROAD, 38.0 FT. WESTERLY OF THE CENTERLINE OF HEWES, AND 2.7 FT. SOUTHEASTERLY OF THE CORNER OF A 6 FT. HIGH CHAIN LINK FENCE. MONUMENT IS SET LEVEL WITH THE SIDEWALK.

NO
LOCATION
MAP