

Designation: 3B-72-68

Date Destroyed:

Date Revised: 4/20/2014

GPS #:

OCS Index Map: Q12-01


Page/Grid: 829/H-4

City / Location: Santa Ana

Line #/SSN: 402/0550

Established By: OCS 1968

Monument Type: Orange County Surveyor's 3 3/4"
Aluminum Disk

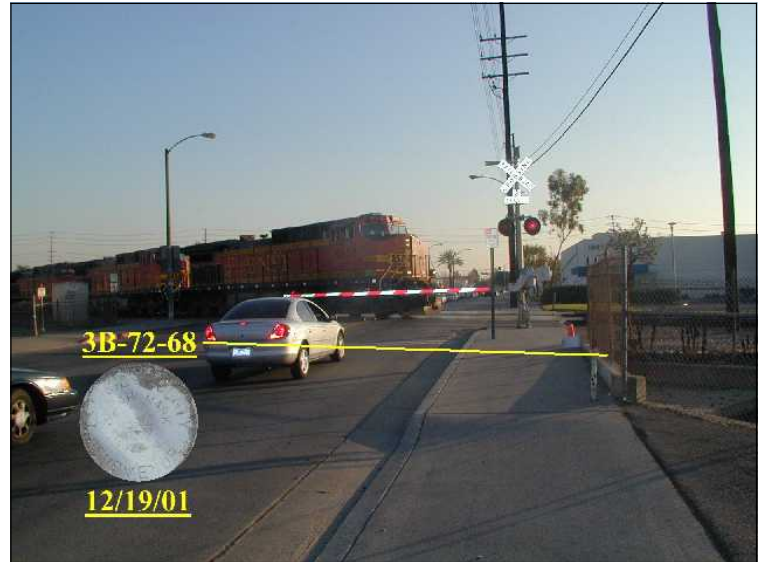

NAVD88 (ft)	NGVD29 (ft)	Year Leveled
110.561	108.143	2010
111.084	108.636	1991

For Reconnaissance Only!	
Latitude (30' +/-)	Longitude (30' +/-)
33 44 07.41	117 50 42.15

Description:

DESCRIBED BY OCS 2001 - FOUND 3 3/4" OCS ALUMINUM BENCHMARK DISK STAMPED "3B-72-68", SET IN THE EASTERLY CORNER OF A CONCRETE WING WALL. MONUMENT IS LOCATED IN THE NORTHWEST CORNER OF THE INTERSECTION OF LYON STREET AND THE SANTA FE TOPEKA RAILWAY, 34 FT. NORTHWESTERLY OF THE MOST NORTHERLY RAIL AND 30 FT. WESTERLY OF THE CENTERLINE OF LYON STREET, 17.5 FT. NORTHEASTERLY OF POWER POLE #SFE 54. MONUMENT IS SET DOWN 1.0 FT. FROM SIDEWALK.

