

Designation: 3F-109-78

Date Destroyed: 8/7/2012

Date Revised:

GPS #:

OCS Index Map: Q17-02


Page/Grid: 891/F-7

City / Location: Laguna Hills

Line #/SSN: 356/0040

Established By: OCS 1978

Monument Type: Orange County Surveyor's 3 3/4"
Aluminum Disk

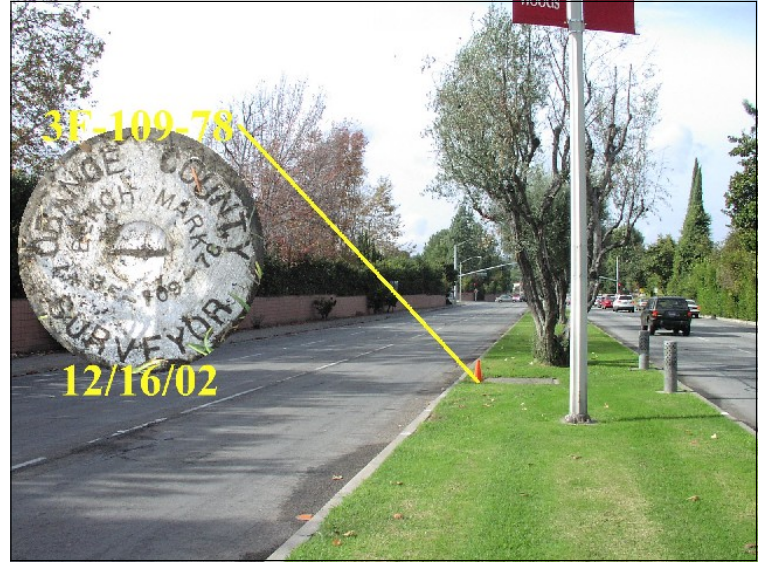

NAVD88 (ft)	NGVD29 (ft)	Year Leveled
360.197	357.840	1991

For Reconnaissance Only!	
Latitude (30' +/-)	Longitude (30' +/-)
33 36 45.7	117 42 59.7

Description:

REPORTED DESTROYED (SEE DATE IN DESTROYED BOX) - ORIGINAL DESCRIPTION BEING: DESCRIBED BY OCS 2002 - FOUND 3 3/4" OCS ALUMINUM BENCHMARK DISK STAMPED "3F-109-78", SET IN THE SOUTHEASTERLY CORNER OF A 5 FT. BY 5 FT. CONCRETE VAULT. MONUMENT IS LOCATED ALONG THE CENTER MEDIAN OF EL TORO ROAD, 0.1 MILES EASTERLY OF THE CENTERLINE OF AVENIDA SEVILLA AND 5.6 FT. SOUTHERLY OF THE CENTERLINE OF EL TORO ROAD. MONUMENT IS SET LEVEL WITH THE SIDEWALK.

NO
LOCATION
MAP