


Designation: 3F-114-82

Date Destroyed: 7/14/2016
Date Revised: 4/7/2004
GPS #: 1508
OCS Index Map: Q12-11
Page/Grid: 860/D-5
City / Location: Irvine

Line #/SSN: 356/0310
Established By: OCS 1982
Monument Type: Orange County Surveyor's 3 3/4" Aluminum Disk

DESTROYED

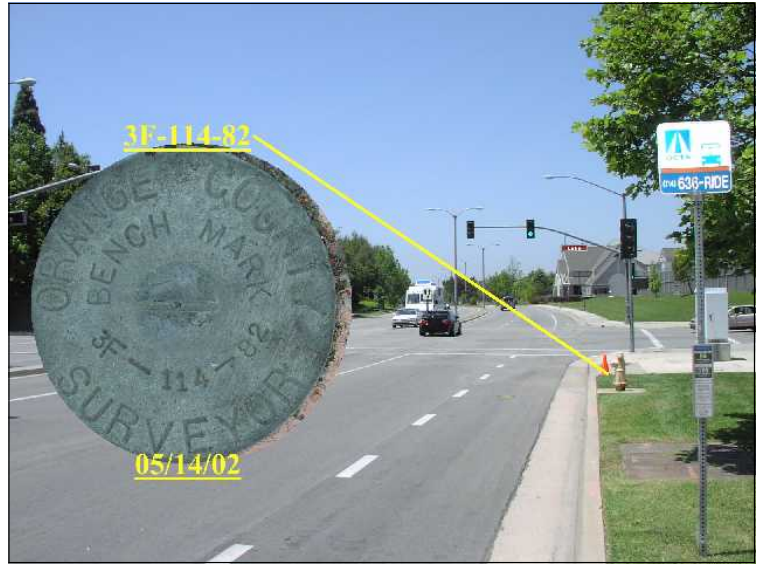

NAVD88 (ft)	NGVD29 (ft)	Year Leveled
89.503	87.108	2003
89.526	87.131	1991

For Reconnaissance Only!	
Latitude (30' +/-)	Longitude (30' +/-)
33 40 33.22675	117 48 15.78522

Description:

DESCRIBED BY OCS 2002 - FOUND 3 3/4" OCS ALUMINUM BENCHMARK DISK STAMPED "3F-114-82", SET IN THE SOUTHEASTERLY CORNER OF A 4.3 FT. BY 15 FT. CONCRETE CATCH BASIN. MONUMENT IS LOCATED IN THE EASTERLY CORNER OF THE INTERSECTION OF LAKE ROAD AND ALTON PARKWAY, 41.5 FT. NORTHEASTERLY OF THE CENTERLINE OF ALTON AND 82 FT. SOUTHEASTERLY OF THE CENTERLINE OF LAKE. MONUMENT IS SET LEVEL WITH THE SIDEWALK.

