

Designation: 3NN-10-80

Date Destroyed:

Date Revised:

GPS #:

OCS Index Map: Q18-07


Page/Grid: 923/J-4

City / Location: Caspers Reg. Park

Line #/SSN: 379/0100

Established By: OCS 1980

Monument Type: Orange County Surveyor's 3 3/4"
Aluminum Disk

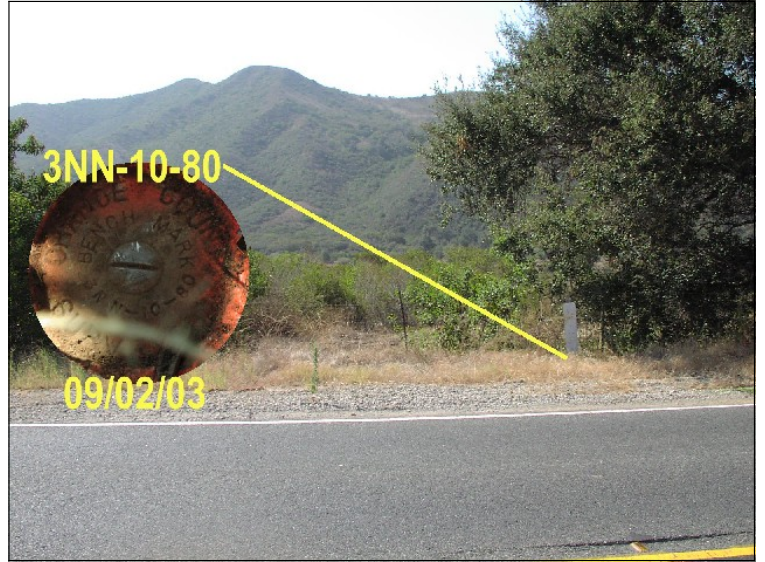

NAVD88 (ft)	NGVD29 (ft)	Year Leveled
623.820	621.483	1992

For Reconnaissance Only!	
Latitude (30' +/-)	Longitude (30' +/-)
33 34 44.23	117 32 01.25

Description:

DESCRIBED BY OCS 2003 - FOUND 3 3/4" OCS ALUMINUM BENCHMARK DISK STAMPED "3NN-10-80", SET IN THE TOP OF A 6 IN. BY 6 IN. CONCRETE POST. MONUMENT IS LOCATED ALONG THE SOUTHERLY SIDE OF ORTEGA HIGHWAY, 11 MILES NORTHEASTERLY ALONG ORTEGA FROM THE CENTERLINE OF THE INTERSTATE 5 FREEWAY, 1.55 MILES SOUTHWESTERLY OF THE SAN JUAN FIRE STATION, 51.3 FT. SOUTHWESTERLY OF POWER POLE (#P128442", 17.5 FT. SOUTHEASTERLY OF THE EDGE OF ORTEGA HIGHWAY AND OCS PADDLEBOARD 1 FT. NORTHERLY FROM MONUMENT. MONUMENT IS SET DOWN 0.1 FT. FROM GRADE.

