

Designation: 404-7-68

Date Destroyed:

Date Revised:

GPS #:

OCS Index Map: Q06-02


Page/Grid: 738/E-7

City / Location: Fullerton

Line #/SSN: 404/0070

Established By: OCS 1968

Monument Type: Orange County Surveyor's 3 3/4"
Aluminum Disk

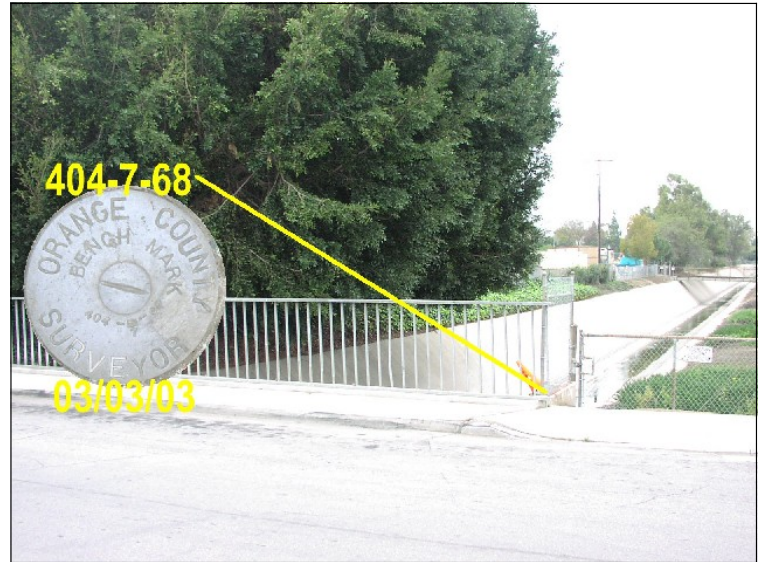

NAVD88 (ft)	NGVD29 (ft)	Year Leveled
122.572	120.149	2005
122.630	120.201	1990

For Reconnaissance Only!	
Latitude (30' +/-)	Longitude (30' +/-)
33 52 06.58	117 57 02.73

Description:

DESCRIBED BY OCS 2003 - FOUND 3 3/4" OCS ALUMINUM BENCHMARK DISK STAMPED "404-7-68", SET IN THE TOP OF A STEEL POST FILLED WITH CONCRETE. MONUMENT IS LOCATED IN THE NORTHWESTERLY CORNER OF THE INTERSECTION OF BASQUE AVENUA AND A FLOOD CONTROL CROSSING, 0.15 MILES NORTHERLY ALONG BASQUE FROM THE CENTERLINE OF VALENCIA AVENUE, 25 FT. WESTERLY OF THE CENTERLINE OF BASQUE, AND 25 FT. NORTHERLY OF THE CENTERLINE OF THE FLOOD CONTROL CHANNEL. MONUMENT IS SET LEVEL WITH THE SIDEWALK.

