


Designation: AP-02-99

Date Destroyed: **5/28/2013**
 Date Revised: 5/13/1999
 GPS #:
 OCS Index Map: Q18-13
 Page/Grid: 952/H-5
 City / Location: Unin., Orange Co.

 Line #/SSN: 731/0020
 Established By: OCS 1999
 Monument Type: Orange County Surveyor's 3 3/4"
 Aluminum Disk

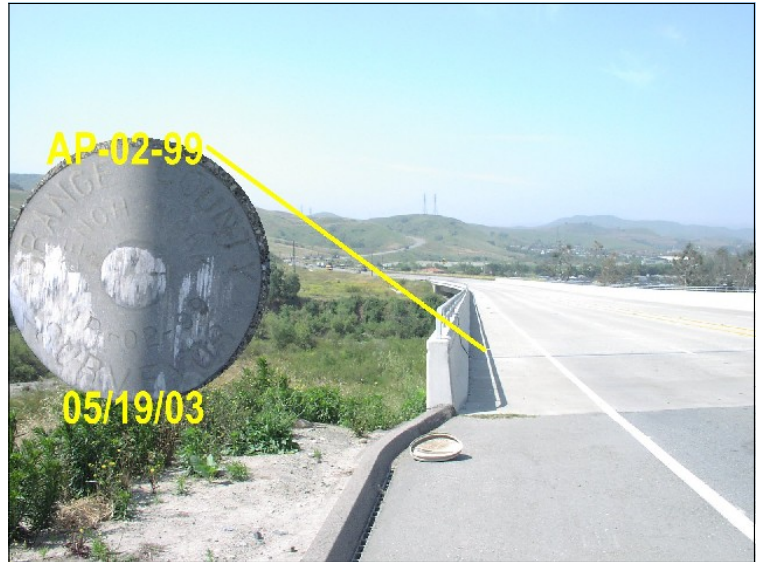

NAVD88 (ft)	NGVD29 (ft)	Year Leveled
238.113	235.793	2004
238.113	235.793	1999

For Reconnaissance Only!	
Latitude (30' +/-)	Longitude (30' +/-)
33 31 28.55975	117 37 08.60413

Description:

REPORTED DESTROYED (SEE DATE IN DESTROYED BOX - ORIGINAL DESCRIPTION BEING: DESCRIBED BY OCS 2003 - FOUND 3 3/4" OCS ALUMINUM BENCHMARK DISK STAMPED "AP-02-99" SET IN THE NORTHEASTERLY CORNER OF A CONCRETE BRIDGE DECK. MONUMENT IS LOCATED IN THE NORTHEASTERLY CORNER OF ANTONIO PARKWAY AND ITS OVERCROSSING OF SAN JUAN CREEK, 1 FT. SOUTHERLY OF THE NORTHERLY EDGE OF THE BRIDGE DECK AND 1 FT. WESTERLY OF THE EASTERLY GUARD RAIL. MONUMENT IS SET LEVEL WITH THE BRIDGE DECK.

NO
LOCATION
MAP