

## Designation: C-783

Date Destroyed:

Date Revised: 4/7/2004

GPS #:

OCS Index Map: Q16-10


Page/Grid: 920/C-7

City / Location: Crystal Cove

Line #/SSN: 400/0500

Established By: USC & GS 1946

Monument Type: Bronze / Brass Disk

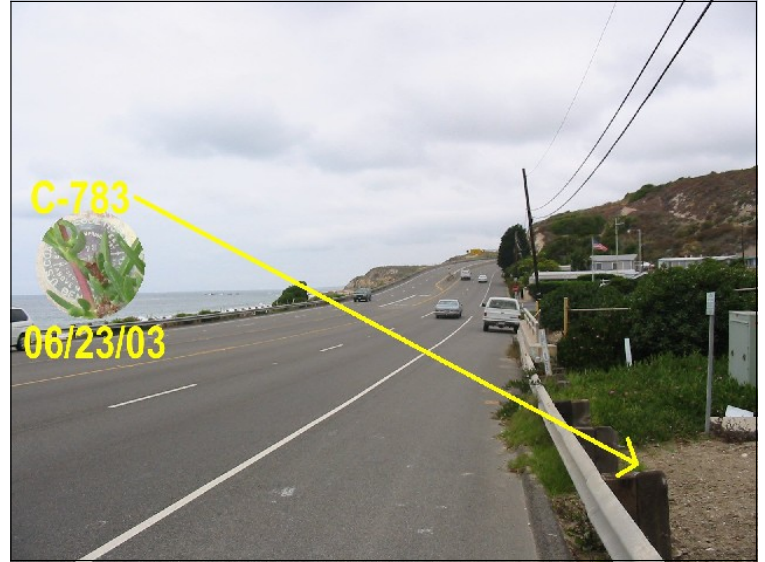

NAVD88 (ft)	NGVD29 (ft)	Year Leveled
20.189	17.849	2004
20.174	17.843	1988

For Reconnaissance Only!	
Latitude (30' +/-)	Longitude (30' +/-)
33 33 38.72	117 49 17.66

### Description:

DESCRIBED BY OCS 2003 - FOUND 3 3/4" USCGS BRONZED DISK STAMPED "C 783 1946", SET IN THE TOP OF A CONCRETE BRIDGE ABUTMENT. MONUMENT IS LOCATED ALONG THE EASTERLY SIDE OF PACIFIC COAST HIGHWAY, 2.5 MILES NORTHERLY OF THE CENTERLINE OF BROADWAY (RTE #1330) IN LAGUNA BEACH TO A CONCRETE BRIDGE, 44.4 FT. EASTERLY OF THE CENTERLINE OF PCH AND 2.9 FT. EASTERLY OF THE EASTERLY GUARD RAIL OF THE BRIDGE. MONUMENT IS SET 1.0 FT. BELOW THE HIGHWAY SURFACE.

