

**Designation: CMM-H11-74**

Date Destroyed:

Date Revised:

GPS #:

OCS Index Map: Q10-07


Page/Grid: 857/C-2

City / Location: Huntington Beach

Line #/SSN: 624/0040

Established By: OCS 1974

Monument Type: Orange County Surveyor's 3 3/4"  
Aluminum Disk

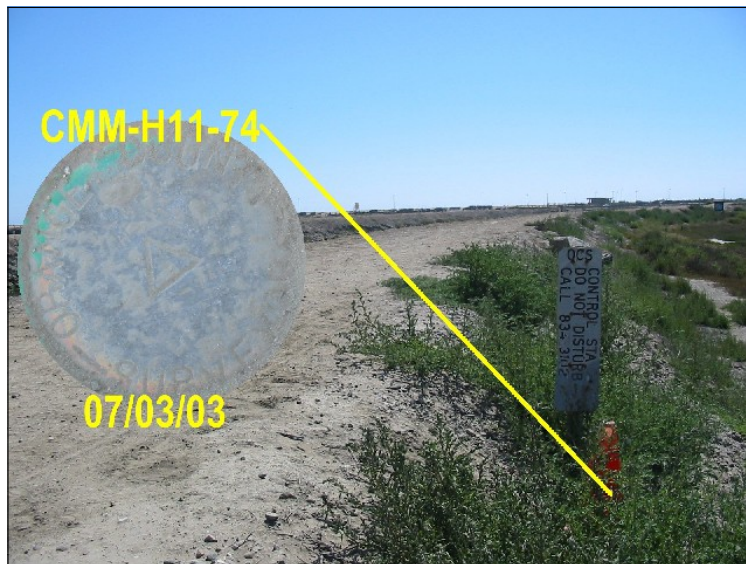

NAVD88 (ft)	NGVD29 (ft)	Year Leveled
10.770	8.354	2005
10.873	8.441	1992

For Reconnaissance Only!	
Latitude (30' +/-)	Longitude (30' +/-)
33 42 12.1	118 03 01.4

**Description:**

DESCRIBED BY OCS 2003 - FOUND 3 3/4" OCS ALUMINUM BENCHMARK DISK STAMPED "CMM-H11-74", SET IN THE TOP OF A 20 IN. DIAMETER CONCRETE POST. MONUMENT IS LOCATED ALONG THE NORTHERLY LEVEE OF THE GARDEN GROVE WINTERSBURG CHANNEL, 1.25 MILES WESTERLY ALONG THE NORTHERLY LEVEE ROAD FROM THE CENTERLINE OF GRAHAM STREET, 9.6 FT. NORTHERLY OF THE CENTERLINE OF THE LEVEE AND 2.8 FT. EASTERLY OF AN OCS STEEL PADDLEBOARD WITNESS POST. MONUMENT IS SET 1.5 FT. LOWER THAN THE LEVEE ROAD.

