

Designation: F-37

Date Destroyed:

Date Revised:

GPS #:

OCS Index Map: Q07-02


Page/Grid: 740/A-7

City / Location: Placentia

Line #/SSN: 403/0650

Established By: USC & GS 1924

Monument Type: Bronze / Brass Disk

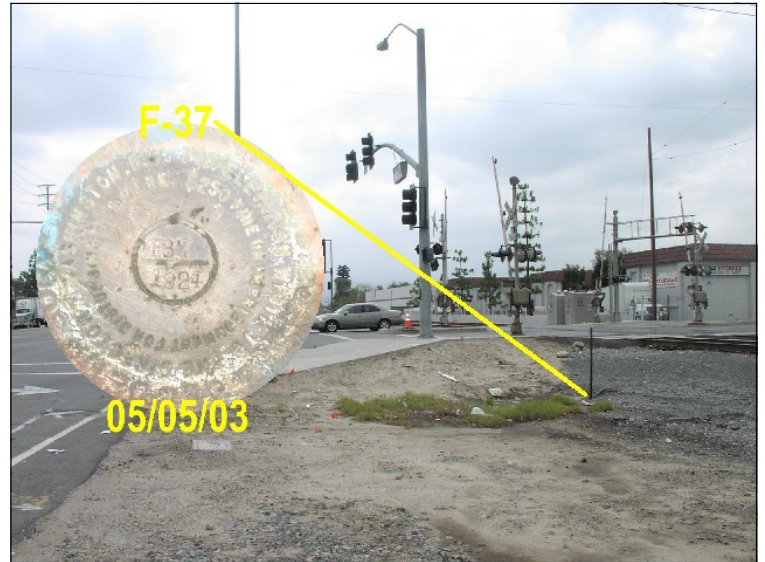

NAVD88 (ft)	NGVD29 (ft)	Year Leveled
253.368	250.968	2006
253.395	251.009	1988

For Reconnaissance Only!	
Latitude (30' +/-)	Longitude (30' +/-)
33 52 02.86	117 49 34.49

Description:

DESCRIBED BY OCS 2003 - FOUND 3 3/4" USCGS BRONZED DISK STAMPED "F 37 1924", SET IN THE WESTERLY END OF A CONCRETE HEADWALL. MONUMENT IS LOCATED IN THE SOUTHWESTERLY CORNER OF THE INTERSECTION OF RICHFIELD ROAD AND ORANGETHORPE AVENUE, 51 FT. SOUTHERLY OF THE CENTERLINE OF ORANGETHORPE, 68.2 FT. WESTERLY OF THE CENTERLINE OF RICHFIELD AND 19.4 FT. NORTHERLY OF THE NORTHERLY RAIL ALONG THE ATCHINSON/TOPEKA/SANTA FE RAILWAY. MONUMENT IS SET 1 FT. BELOW THE SURFACE OF THE ROAD.

