

**Designation: F-582**

Date Destroyed:

Date Revised: 8/14/2017

GPS #:

OCS Index Map: Q08-13


Page/Grid: 801/B-5

City / Location: Unin., Orange Co.

Line #/SSN: 354/0380

Established By: USC & GS 1939

Monument Type: Bronze / Brass Disk

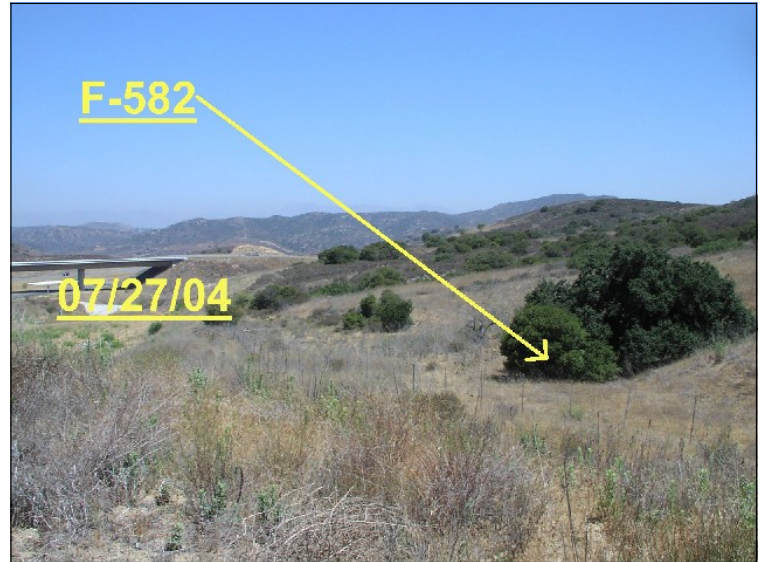

NAVD88 (ft)	NGVD29 (ft)	Year Leveled
792.780	790.368	2017
792.780	790.368	1999
792.852	790.439	1991

For Reconnaissance Only!	
Latitude (30' +/-)	Longitude (30' +/-)
33 46 46.37	117 44 47.73

**Description:**

DESCRIBED BY OCS 2017 - FOUND 3 3/4" USC&GS BRONZED DISK STAMPED "F 582 1939", SET IN THE TOP OF A CONCRETE POST. MONUMENT IS LOCATED NEAR AND UNDER AN OAK TREE, EAST 200' +/- FROM THE CENTER OF OF SANTIAGO CANYON ROAD AND SOUTH 1000' +/- FROM THE 241 TOLL ROAD NORTH ONRAMP.

