

Designation: GG-128

Date Destroyed:

Date Revised:

GPS #:

OCS Index Map: Q06-10


Page/Grid: 798/F-5

City / Location: Garden Grove

Line #/SSN:

Established By: KDM Survey 2012

Monument Type: Bronze / Brass Disk

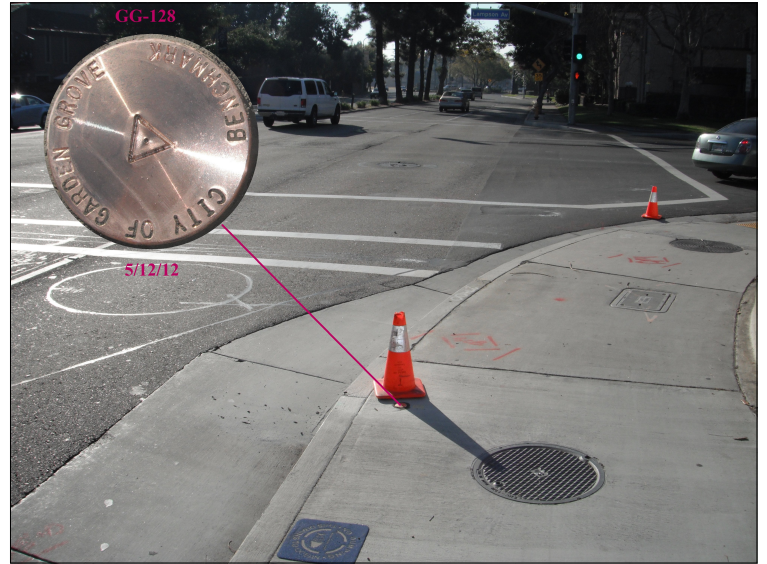

NAVD88 (ft)	NGVD29 (ft)	Year Leveled
94.031	91.613	2012

For Reconnaissance Only!	
Latitude (30' +/-)	Longitude (30' +/-)
33 46 53.81364	117 56 28.38192

Description:

FOUND 2 1/2" BRONZE CITY OF GARDEN GROVE BENCHMARK DISK WITH PUNCH IN TRIANGLE, SET IN THE SOUTHEAST CORNER OF A 10 FT. BY 4 FT. CONCRETE CATCH BASIN. MONUMENT IS LOCATED IN THE NORTHWEST CORNER OF THE INTERSECTION OF LAMPSON AVE. AND EUCLID AVE. AT THE B.C.R. AND 1.5 FT. WEST OF THE CURB FACE.

