


Designation: LP-13-81

Date Destroyed:
Date Revised: 1/22/2014
GPS #:
OCS Index Map: Q21-05
Page/Grid: 973/A-6
City / Location: San Clemente

Line #/SSN: 380/0030
Established By: OCS 1981
Monument Type: Orange County Surveyor's 3 3/4"
 Aluminum Disk

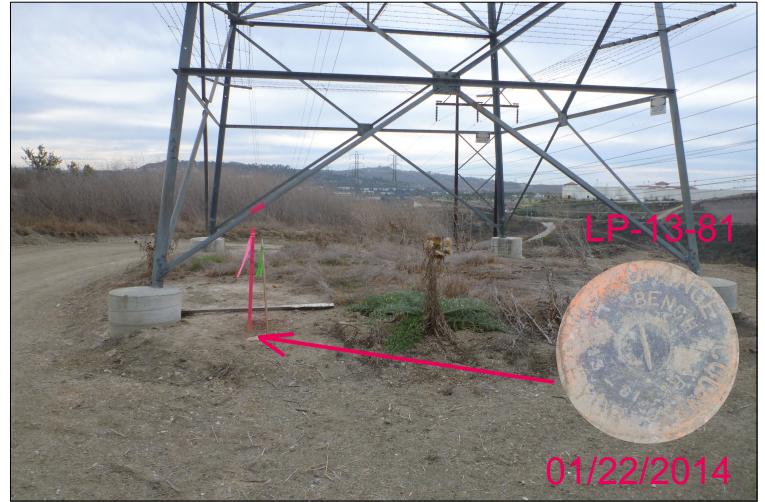

NAVD88 (ft)	NGVD29 (ft)	Year Leveled
418.945	416.643	1991

For Reconnaissance Only!	
Latitude (30' +/-)	Longitude (30' +/-)
33 28 06.23026	117 36 17.26157

Description:
 DESCRIBED BY OCS 2014 - FOUND 3 3/4" OCS ALUMINUM BENCHMARK DISK STAMPED "LP-13-81" SET IN CONCRETE POST, FLUSH WITH GROUND. BENCHMARK IS LOCATED 3' +/- NORTHWESTERLY FROM THE NORTHEASTERLY LEG OF A TRANSMISSION TOWER.

