

**Designation: Z-567**

Date Destroyed:

Date Revised: 1/21/2004

GPS #:

OCS Index Map: Q13-08


Page/Grid: 832/E-7

City / Location: Modjeska Canyon

Line #/SSN: 387/0040

Established By: USC & GS 1939

Monument Type: Bronze / Brass Disk

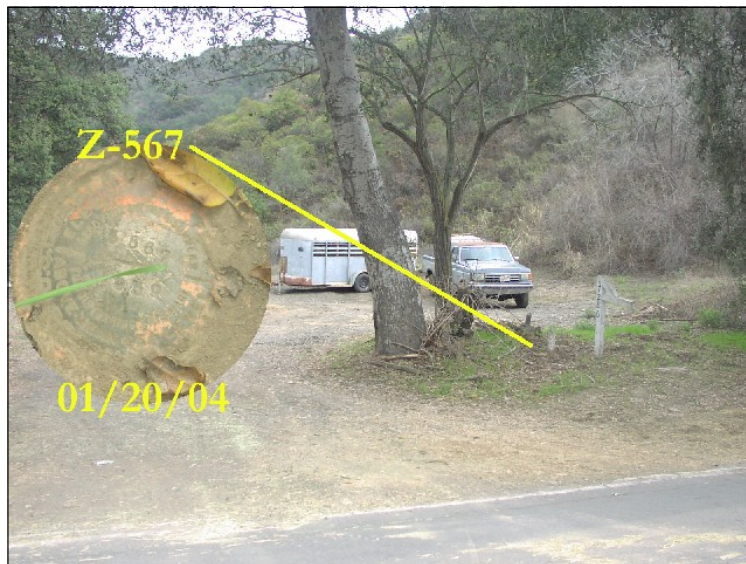

NAVD88 (ft)	NGVD29 (ft)	Year Leveled
1260.186	1257.809	1995

For Reconnaissance Only!	
Latitude (30' +/-)	Longitude (30' +/-)
33 42 42.70	117 38 26.11

**Description:**

DESCRIBED BY OCS 2004 - FOUND 3 3/4" USGS BRONZED DISK STAMPED "Z 567 1939", SET IN THE TOP OF A CONCRETE POST. MONUMENT IS LOCATED ALONG THE NORTHEASTERLY SIDE OF MODJESKA CANYON ROAD, 0.5 MILES SOUTHEASTERLY ALONG MODJESKA CANYON ROAD FROM THE CENTERLINE OF SANTIAGO CANYON ROAD, 29 FT. NORTHEASTERLY OF THE CENTERLINE OF MODJESKA CANYON AND 1.7 FT. NORTHERLY OF A WOODEN WITNESS POST. MONUMENT IS SET 0.2 FT. BELOW GROUND LEVEL.

