Vertical Control Data Sheet
O.C.S. 1995 Adjustment

Designation: 1A-121-68

Date Destroyed:
Date Revised:
GPS #:
OCS Index Map: Q02-13
Page/Grid: 737/H-6
City / Location: Buena Park

Line #/SSN: 402/0950
Established By: OCS 1968
Monument Type: Orange County Surveyor's 3 3/4" Aluminum Disk

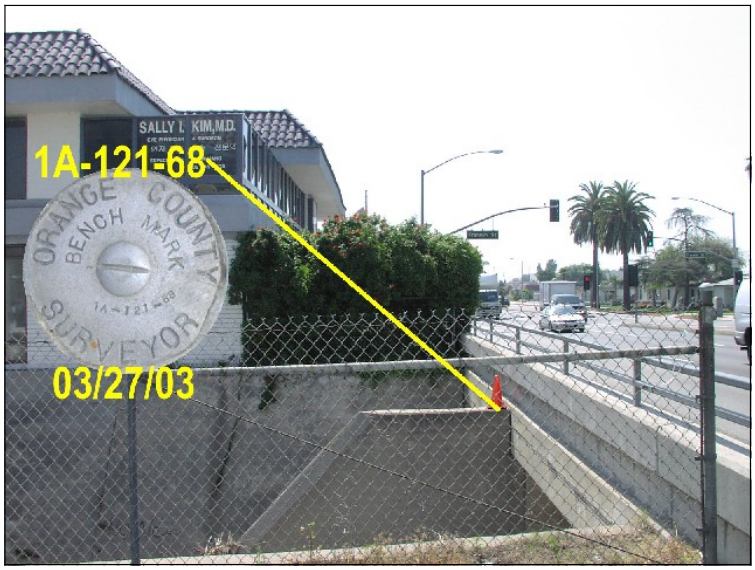

NAVD88 (ft)	NGVD29 (ft)	Year Leveled
79.643	77.214	2005
79.691	77.252	1990

For Reconnaisance Only!	
Latitude (30' +/-)	Longitude (30' +/-)
33 52 38.25	117 59 53.21
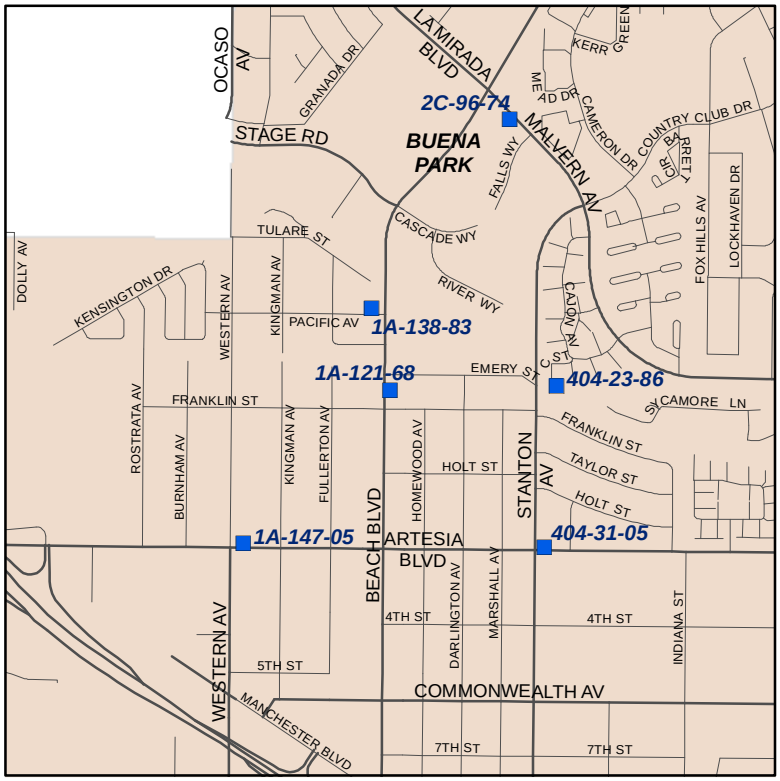
Description:
DESCRIBED BY OCS 2003 - FOUND 3 3\4" OCS ALUMINUM BENCHMARK DISK STAMPED "1A-121-68", SET IN THE TOP OF A CONCRETE WINGWALL FOR A BRIDGE OVER A VERTICAL WALL CHANNEL. MONUMENT IS LOCATED ALONG THE EASTERLY SIDE OF BEACH BOULEVARD, 170 FT. NORTHERLY SIDE OF FRANKLIN STREET, 47 FT. EASTERLY OF BEACH BOULEVARD AND 1 FT. EASTERLY OF THE EASTERLY GUARD RAIL ALONG BRIDGE. MONUMENT IS SET LEVEL WITH THE SIDEWALK.