Designation: 3E-101-79

Date Destroyed:

Date Revised:

GPS #:

OCS Index Map: Q17-03

Page/Grid: 892/C-5

City / Location: Mission Viejo

Line #/SSN: 355/0050

Established By: OCS 1979

Monument Type: Orange County Surveyor's 3 3/4" Aluminum Disk

NAVD88 (ft)	NGVD29 (ft)	Year Leveled
662.476	660.124	1990

For Reconnaisance Only!	
Latitude (30' +/-)	Longitude (30' +/-)
33 37 21.29	117 39 37.23

Description:
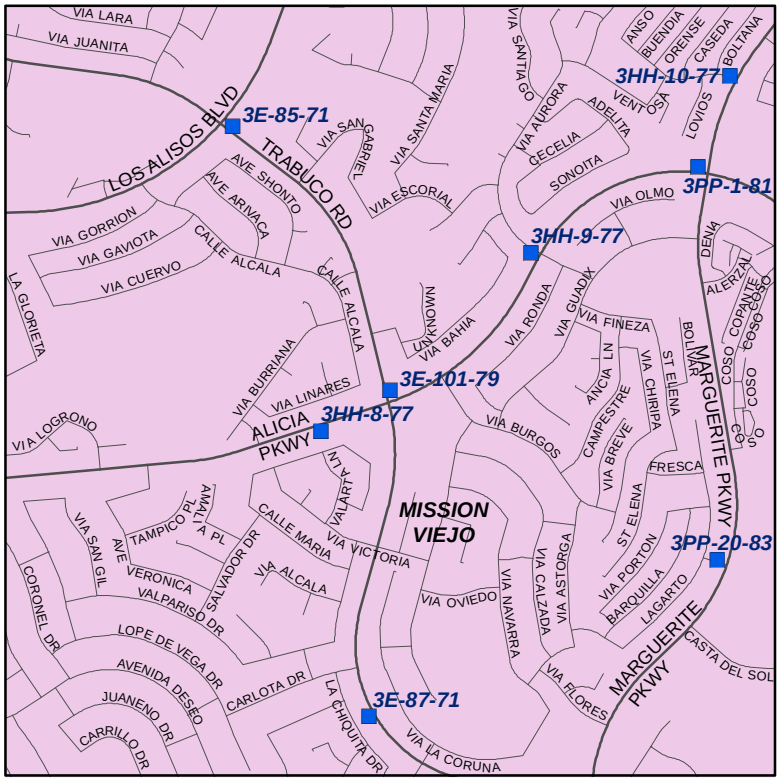
DESCRIBED BY OCS 2003 - FOUND 3 3\4" OCS ALUMINUM BENCHMARK DISK STAMPED "3E-101-79", SET IN THE SOUTHWESTERLY CORNER OF AN 11 FT. BY 3.5 FT. CONCRETE CATCH BASIN. MONUMENT IS LOCATED IN THE NORTHEASTERLY CORNER OF THE INTERSECTION OF ALICIA PARKWAY AND TRABUCO ROAD, 90 FT. NORTHERLY OF THE CENTERLINE OF ALICIA AND 38 FT. EASTERLY OF THE CENTERLINE OF THE MEDIAN ALONG TRABUCO. MONUMENT IS SET LEVEL WITH THE SIDEWALK.