

Designation: N-1415

Date Destroyed:

Date Revised: 4/7/2004

GPS #: 1481

OCS Index Map: Q20-06


Page/Grid: 971/G-6

City / Location: Dana Point

Line #/SSN: 400/0230

Established By: NGS 1988

Monument Type: Bronze / Brass Disk

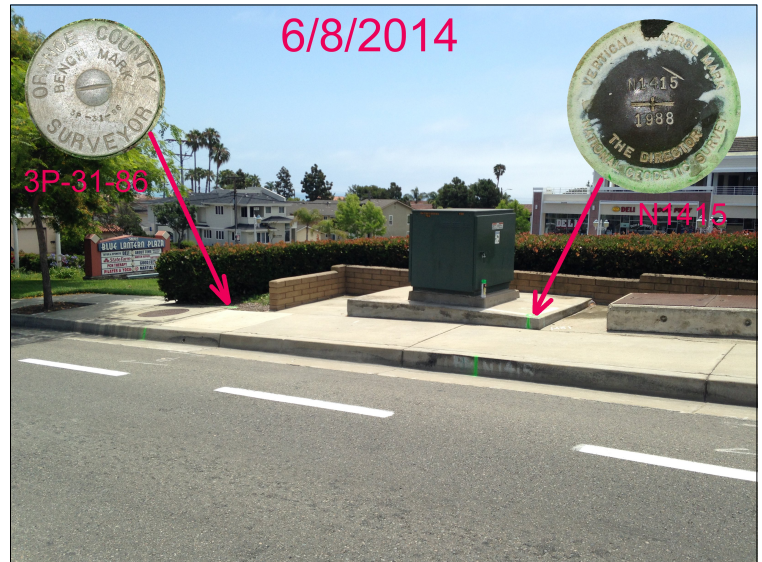

NAVD88 (ft)	NGVD29 (ft)	Year Leveled
195.627	193.324	2004
195.587	193.284	1989

For Reconnaissance Only!	
Latitude (30' +/-)	Longitude (30' +/-)
33 27 55.30921	117 42 25.87940

Description:

DESCRIBED BY OCS 2003 - FOUND 3 3/4" NGS BRONZED DISK STAMPED "N 1415 1988", SET IN THE NORTHEASTERLY CORNER OF A CONCRETE FOOTING FOR A LARGE CONTROL BOX. MONUMENT IS LOCATED IN THE NORTHWESTERLY CORNER OF THE INTERSECTION OF PACIFIC COAST HIGHWAY AND BLUE LANTERN, 154 FT. NORTHWESTERLY OF THE CENTERLINE OF BLUE LANTERN AND 25.9 FT. SOUTHERLY OF THE CENTERLINE OF THE SOUTHBOUND LANES OF PCH. MONUMENT IS SET UP 0.3 FT. ABOVE SIDEWALK.

