

VERTICAL CONTROL DATA SHEET O.C.S. 1995 ADJUSTMENT



Designation: 601-43R-88

Date Destroyed:

Date Revised:

GPS #:

OCS Index Map: Prado
Page/Grid: N/A
City / Location: Corona


Line #/SSN:

Established By: OCS

Monument Type: Orange County Surveyor's 3 3/4"

Aluminum Disk

NAVD88 (ft)	NGVD29 (ft)	Year Leveled

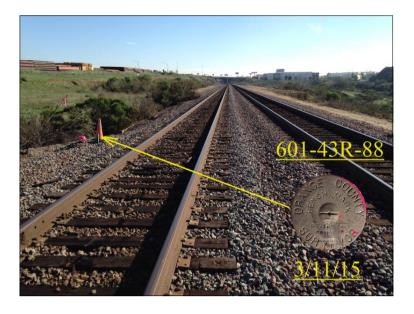

For Reconnaisance Only!		
Latitude (30' +/-)	Longitude (30' +/-)	
33 53 00.60	117 37 59.20	

Description:

SET IN EXISTING RIVERSIDE COUNTY POST FOUND WITH CAP BROKEN OFF. STATION IS LOCATED 4.0 MILES W'LY OF CORONA ALONG S.T. & S.F. R.R. 0.3 MILES W'LY ALONG R.R. FROM 91 FREEWAY OVERCROSSING. 13' N'LY CENTERLINE TRACKS. 1.0' LOWER THAN TRACKS 6' E'LY RAILROAD SIGNAL FOOTING.

