

Designation: PB-12-15

Date Destroyed:

Date Revised:

GPS #:

OCS Index Map: Prado

Page/Grid: N/A

City / Location: Chino

Line #/SSN:

Established By: OCS 2015

Monument Type: Orange County Surveyor's 4"
Aluminum Disk




NAVD88 (ft)	NGVD29 (ft)	Year Leveled
582.420	580.055	2015

For Reconnaissance Only!	
Latitude (30' +/-)	Longitude (30' +/-)
33 58 05.84	117 40 17.68

Description:

DESCRIBED BY OCS 2015 - FOUND 4" OCS ALUMINUM DISK, STAMPED "PB-12-15", IN THE SE'LY CORNER OF 15' X 4' CATCH BASIN, 0.4 MILES E'LY OF THE INTERSECTION OF EL PRADO ROAD & KIMBALL AVENUE, 30' S'LY OF THE CENTERLINE OF KIMBALL AVENUE, 45' W'LY OF THE APPROXIMATE CENTERLINE OF MAGNOLIA FLOOD CONTROL CHANNEL.

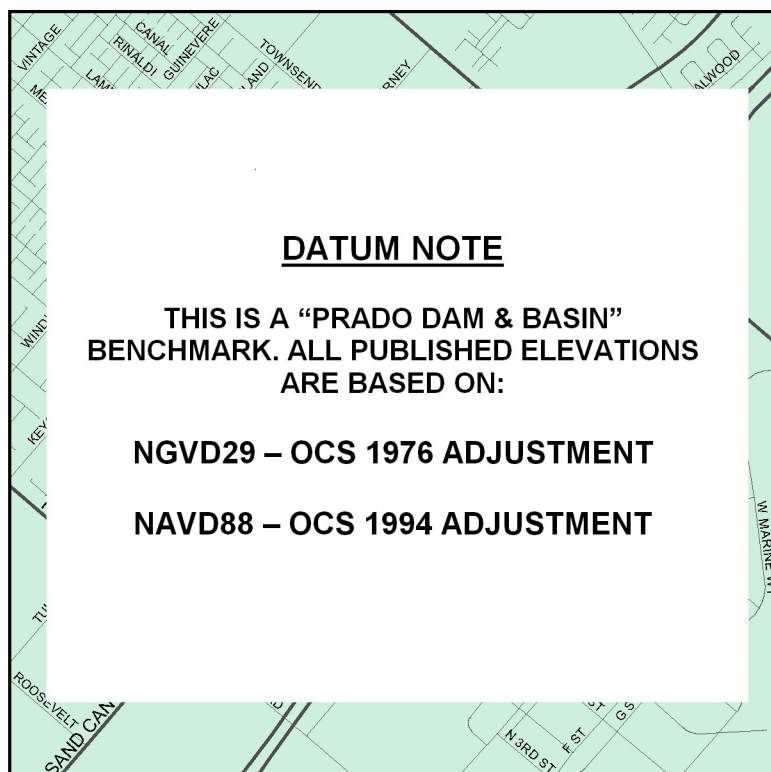

DATUM NOTE

THIS IS A "PRADO DAM & BASIN" BENCHMARK. ALL PUBLISHED ELEVATIONS ARE BASED ON:

NGVD29 – OCS 1976 ADJUSTMENT

NAVD88 – OCS 1994 ADJUSTMENT