

## Designation: PB-17-15

Date Destroyed:

Date Revised:

GPS #:

OCS Index Map: Prado

Page/Grid: N/A

City / Location: Chion

Line #/SSN:

Established By: OCS 2015

Monument Type: Orange County Surveyor's 4"  
Aluminum Disk




NAVD88 (ft)	NGVD29 (ft)	Year Leveled
570.341	567.976	2015

For Reconnaissance Only!	
Latitude (30' +/-)	Longitude (30' +/-)
33 57 21.65	117 38 29.03

### Description:

DESCRIBED BY OCS 2015 - FOUND 4" OCS ALUMINUM DISK, STAMPED "PB-17-15", IN THE NW'LY CORNER OF A 11' X 4' CATCH BASIN, IN THE NW'LY QUADRANT OF THE INTERSECTION OF PINE AVENUE & MEADOWHOUSE AVENUE, 40' W'LY OF THE CENTERLINE OF MEADOWHOUSE AVENUE, 90' NW'LY OF THE CENTERLINE OF PINE AVENUE.

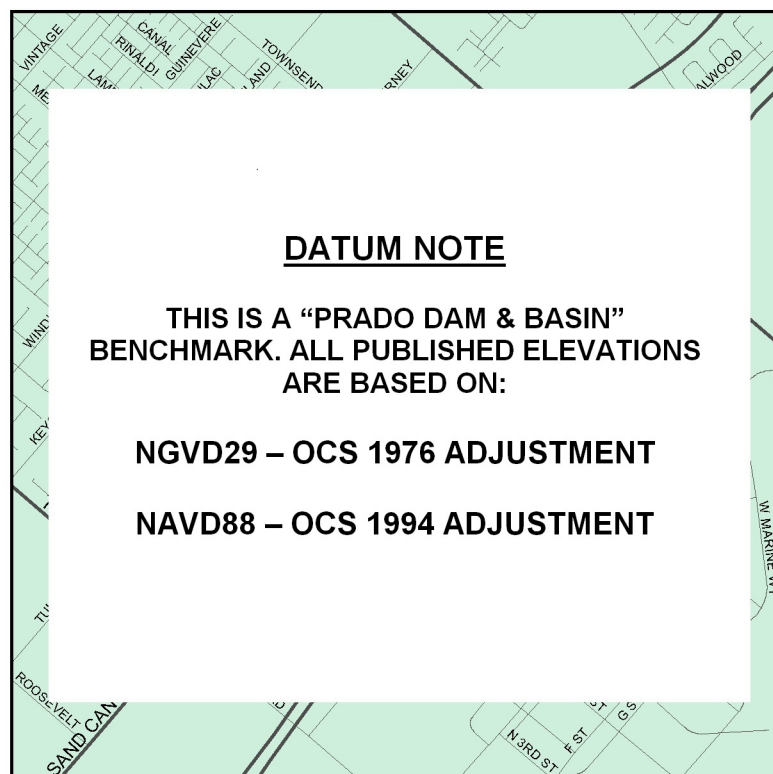

### DATUM NOTE

THIS IS A "PRADO DAM & BASIN" BENCHMARK. ALL PUBLISHED ELEVATIONS ARE BASED ON:

NGVD29 – OCS 1976 ADJUSTMENT

NAVD88 – OCS 1994 ADJUSTMENT